

Kingman

KANSAS

SECTION 1 TOWNSHIP 30 RANGE 8W

WELL NO. #1 Gwen Render (Gwynn)

COMPANY Pickrell Drlg.

NORTH

				0			

WEST

EAST

SOUTH

Kingman

KANSAS


SEC.	1	TWP.	30	R.	8W
------	---	------	----	----	----

WELL NO. #1 Gwen Render FARM

COMPANY Pickrell Drlg

CONTRACTOR Co Tools

\_\_\_\_\_ FT. FROM N. LINE  
 \_\_\_\_\_ FT. FROM S. LINE  
 \_\_\_\_\_ FT. FROM E. LINE  
 \_\_\_\_\_ FT. FROM W. LINE

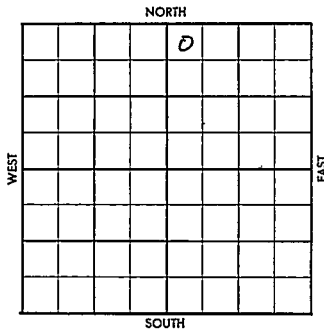

NW NW NE

Gulf - DHM Monsanto - DHM Magnolia - FO

1956	ELEVATION	REPORT
------	-----------	--------

9-5  
 Comm 8-31-56  
 8" @ 160 w/100  
 Drlg 2465

County Kingman Elev. \_\_\_\_\_  
 Sec. 1 Twp. 30 Rgs. SW  
 Company Pickrell Drlg.  
 Farm Name Gwen Render No. 1

Co.

TOPS DEPTH LOG DATUM

Anh.			
TP.			
H.			
Tr.			
Dg.			
Bl.			
L.			
K.C.			
B.K.C.			
Ce.			
C.			
M.			
M.			
K.			
Mz.			
Me.			
V.			
S.			
S.			
A.			
R.			
PE.			
G.			
T.D.			

Loc. in Sec. NW NW NE  
 Geol. \_\_\_\_\_  
 Contr. \_\_\_\_\_  
Co. Tools  
 Pool \_\_\_\_\_

Lse.

0  
 SEP 5 56  
 FIRST REPORT  
 Gulf (DHM)  
 Monsanto (DHM)  
 Magnolia (FO)

T

No.

Sec.

Date Comm. 8/31/56, 8" @ 160 w/100 Drlg. 2465

T.

R.

*[Handwritten scribbles and signatures]*

County Kingman Elev. 1000  
 Sec. 1 Twp. 30 Rge. 8  
 Company Hickrell Drilling  
 Farm Name Green Rander No. 1

TOPS	DEPTH	LOG	DATUM	Loc. in Sec.
Anh.				1/4 N. 1/4
TP.				
H.	3166	3142		
Tr.				
Dg.	sd	3280		
Bl.				
L.	3393	3383		Geol.
K.C.				Contr.
B.K.C.				Co. Tools
Ce.				Pool
C.				
M.	4127	4121		
M.				
K.				
Mz.				
Ma.				
V.				
S.				
S.				
A.				
R.				
PE.				
G.				
TD.	4250			

OCT 21 '56  
 COMPLETE  
 Gulf (Drip)  
 Monsanto (Drip)  
 Magnolia (FO)

Date Comm. 8/21/56, 8" @ 160 w/100 Drig. 21.05  
 SEP 12 '56 KDSF 4126-56 1hr. 6/4" 9a.  
3,200 MCF/45" 9a 3,310/45"  
stabil. near 90' GCM + 60' SW FP  
660-765 BHP 1530/w" CIRC @ 4170  
 SEP 19 '56 DST 4158-92 1hr. 6/2"  
9a 2 Mill. FP 385-425 near  
180' GCM BHP 1540 4 1/2 @  
4248 CO 4217 40/4170-80 40/  
4140-50 24/4122-38 est 2 To 3

MILL CFC ~~36~~ ~~300~~ 300 acid

SEP 26 '56 ~~1779~~ 9a 3.21 MCF

2" T69 CP 560# FV2G F19

Ld + 2,500 MCF <sup>OCT 3 '56</sup> tstg

OCT 1 '56 +st 3,800 MCF GPD

~~1779~~ ~~1779~~ ~~1779~~ <sup>OCT 17 '56</sup> 5.1

OCT 24 '56 OCT 31 '56 OP FLOW 4,789

MCFG SIP 1434#