


SECTION 1 TOWNSHIP 30 RANGE 8W

WELL NO. #2 Gwynn-Render

COMPANY C.R.A.

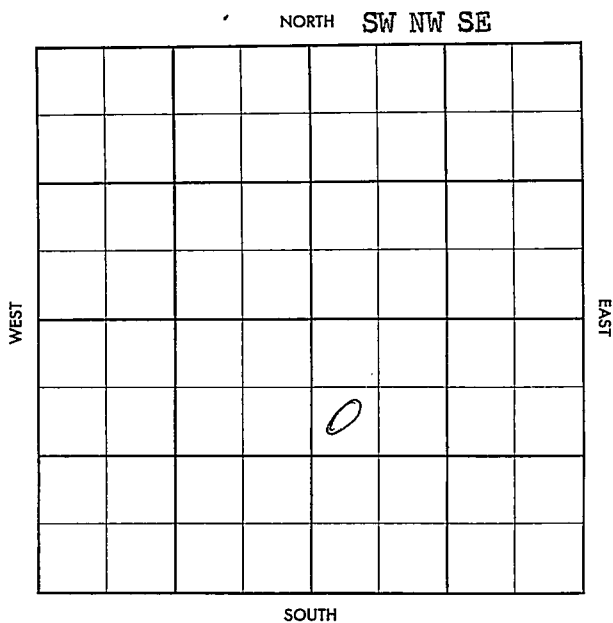

County Kingman Elev. _____
 Sec. 1 Twp. 30 Rge. 8W
 Company C. R. A.
 Farm Name Gwynn-Render No. 2

TOPS	DEPTH	LOG	DATUM
Anh.			
TP.			
H.			
Tr.			
Dg.			
Bl.			
L.			
K.C.			
B.K.C.			
Ce.			
C.			
M.			
M.			
K.			
Mz.			
Me.			
V.			
S.			
S.			
A.			
R.			
PE.			
G.			
T.D.			

Loc. in Sec. SW NW SE
 Geol. _____
 Contr. _____
 Co. Tools _____
 Pool _____
 Spivey-Grabs _____

FIRST REPORT	
AUG 7 '37	
e	

Date Comm. M I R T

~~27~~

Co.
 Sec.
 No.
 Sec.
 T.
 R.

County Kingman Elev. 1555 DA
 Sec. 1 Twp. 30 Rge. 8W
 Company C. R. A.
 FarmName Gwynn-Render No. 2

TOPS	DEPTH	LOG	DATUM	Loc. in Sec.
Anh.				SW NW SE
TP.				
H.	3192			
Tr.				
Dg.				
Bl.				
L.	3428			Geol.
M.C.				Contr.
B.K.C.				Co. Tools
Ce.				
C.				Pool
M.	A 4161			Spivey-Grabs
M.				
K.				
Mz.				
Me.				
V.				
S.				
S.				
A.				
R.				
PE.				
G.				
TD.	4240			

↑
COMPLETE
 OCT. 23 '57
 e

Date Comm.

MIRT .. 8-7-57 85/8 230
 1175 Ø 2955 . 31 DST 4162-82 up
 1 hr G 107" G 2.6, MCE 9" St 2.6 2 1/2 mar
 10 1/2" R. 90' G CMIBHP 1610 FBHP 1482 1/2
 PP 535-584 DST 4102-4202 op 1 hr G
 10 3" G 460, 10 25" R. 85' G CMIBHP 1620
 FBH 1666/20 FP 160-102 Ø Ahead AUG 28 '57
 5 1/2 4239 1/2 1125 MICT CO 4204 1/2
 80/4164-84

1-30-8W

FORM 513-1 SUNRAY

SEP 4 '57 500 acid \$

~~Field ga~~
SEP 11 '57

~~6300 MCF~~ + 519

Alw 1150 + 5.690 MCF pd

3 hrs SI SITD 1400

SEP 25 '57

OCT 2 '57

OCT 9 '57

OCT 23 '57

OCT 23 '57

300 MCF to

~~830~~ pd

1-30-8W

sw nw se