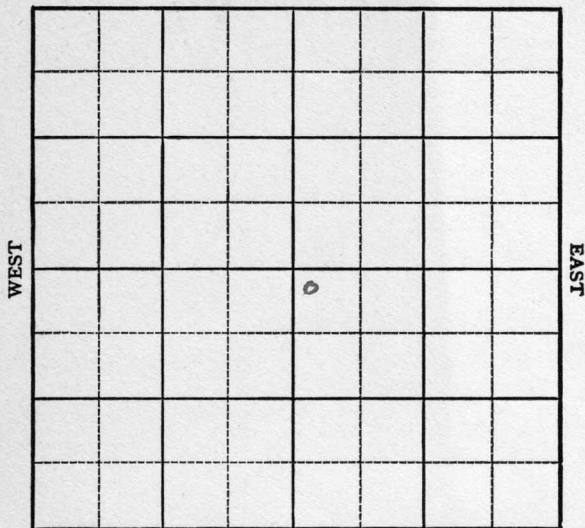


KANSASSection 1 Township 30 Range 37WWell No. 1 FultonCompany Hugoton Prod.Hugoton
NORTH

SOUTH

Grant

KANSAS ✓

Sec. 1 Twp. 30 R. 37W

Well No. #1 Fulton Farm

Hugoton Prod.


Hugoton Pool (Burris Drlg, Cont.) Company

100' Ft. from N. Line

 Ft. from S. Line

100' Ft. from E. Line

 Ft. from W. Line

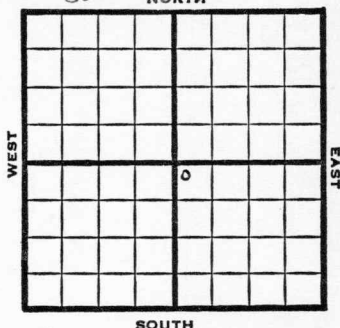

NW SE

SOUTH

1949

Elev. 3078'

REPORT

9/7 Location
9/14 10" @ 605'
Drlg 1485'
9/21 7" @ 2461'
9/28 TD 2470'
10/5 TD 2698'
252' of 5" Perf Liner @ 2698'
10/12 "
10/19 13000 acid
10/26 7" @ 2461'
252' of 5" Perf liner @ 2698
Acid 13000
Gas 22,862,000
R. Pr. 418#
TD 2698'

COMPLETED

Kansa[®]Map No. _____ Sec. 1 Twp. 30 R. 37WWell No. 1 Fulton

Hugoton Prod. _____ Company _____

Burris Drlg. _____ Contractor _____

NW SE

FIRST REPORT
SECTION PLAT100 Ft. from N. Line

_____ Ft. from S. Line

100 Ft. from E. Line

_____ Ft. from W. Line

		o	

Grant County

Location X

Rig up _____

Drilling and Remarks:

RECORD

Cased _____ in., _____ ft.

Sand _____

Gas _____

Oil _____

Total Depth _____

PRODUCTION

1st 24 hrs. Nat. _____

1st 24 hrs. after shot _____

Gas _____ Cu. Ft.

Dry Hole _____

Abandoned _____

Date

SEP 7 1949

19

S. J. LEWIS

Scout

Map No. _____ Sec. 1 Twp. 30 R. 37W

Well No. 1 Fulton

Hugoton Prod.


Company

COMPLETE

Contractor

NW SE

E1,3078
SECTION PLAT

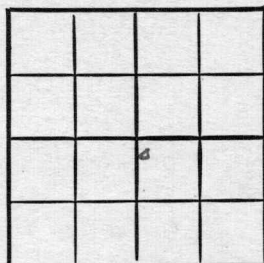

100 Ft. from N. Line

_____ Ft. from S. Line

100 Ft. from E. Line

_____ Ft. from W. Line

Grant County

Location _____

Rig up _____

Drilling and Remarks:

7" C2461

252' of 5" Perf. liner

C2468

13000 acid

22,862,000 Gas

418 R/B*

RECORD

Cased _____ in., _____ ft.

Sand _____

Gas _____

Oil _____

Total Depth 2685

PRODUCTION

1st 24 hrs. Nat. _____

1st 24 hrs. after shot _____

Gas _____ Cu. Ft.

Dry Hole _____

Abandoned _____

Date

OCT 26 1949

19

S. J. LEWIS

Scout