

KANSAS


FORM 51 IOM 12-46 PETROL

Stanton county

Section 1 Township 30 Range 39-W

Well No. #1, O'Keefe

Company Stanolind O&G

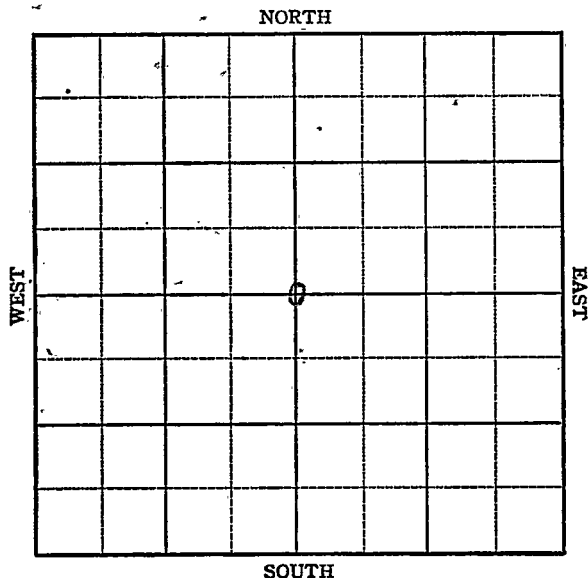

KANSAS

Sec. 1 Twp. 30 R. 39-W

Well No. #1, O'Keefe Farm

Stanolind Oil and Gas Company Company


Hugoton Pool

2640' Ft. from N. Line

 Ft. from S. Line

2640' Ft. from E. Line

 Ft. from W. Line

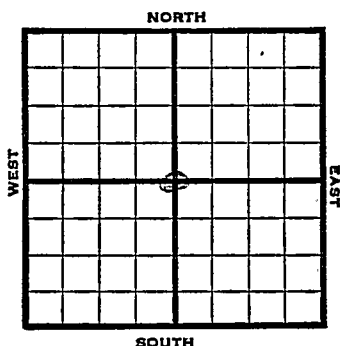

C Section

1947

Elev. 3759'

REPORT

1/22

8" @ 604'
Drlg. 2047'

2/12

5" @ 2511
Perf
17,500 Acid
7,145,000 Gas
365# R Pr
TD 2578'

COMPLETED

Kansas
KANSASMap No. no map Sec. 1 Twp. 30 R. 39WWell No. 1 O'Keefe

Stanolind


Company

~~1st~~ REPORT

Contractor

C Sec.

SECTION PLAT

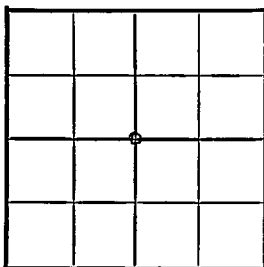2640 Ft. from N. Line Ft. from S. Line2640 Ft. from E. Line Ft. from W. Line

Stanton County

Location Rig up

Drilling and Remarks:

8" @ 604

drlg. 2047

RECORD

Cased in. ft.Sand Gas Oil Total Depth

PRODUCTION

1st 24 hrs. Nat. 1st 24 hrs. after shot Gas Cu. Ft.Dry Hole Abandoned

Date

JAN 22 1947 19

S. J. LEWIS Scout

Map No. _____ Sec. 1 Twp. 30 R. 39W

Well No. 1 O'Keefe

Stanolind Company

COMPLETE

Contractor

C Sec.


E18159
SECTION PLAT

2640 Ft. from N. Line

_____ Ft. from S. Line

2640 Ft. from E. Line

_____ Ft. from W. Line

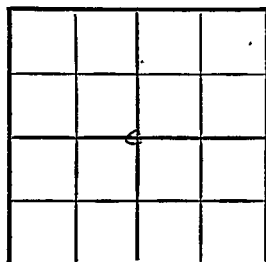

Stanton County

Location _____

Rig up _____

Drilling and Remarks:

5' @ 2511
Perf.
17500 acid
7,145,000 Gas

865# R

RECORD

Cased _____ in.; _____ ft.

Sand _____

Gas _____

Oil _____

Total Depth 2578

PRODUCTION

1st 24 hrs. Nat. _____

1st 24 hrs. after shot _____

Gas _____ Cu. Ft.

Dry Hole _____

Abandoned _____

Date

FEB 12 1947

19

S. I. LEWIS Scout