

Section 10 Township 30 Range 8WWell No. #1 MorrisCompany Beardmore Drig.

NORTH

SOUTH

HOT FILE Kingman KANSAS

SEC.	TWP.	R.
10	30	8 W

WELL NO.

1 Morris

FARM


COMPANY

Beardmore Drlg.

CONTRACTOR

Co. Tools

Wildcat

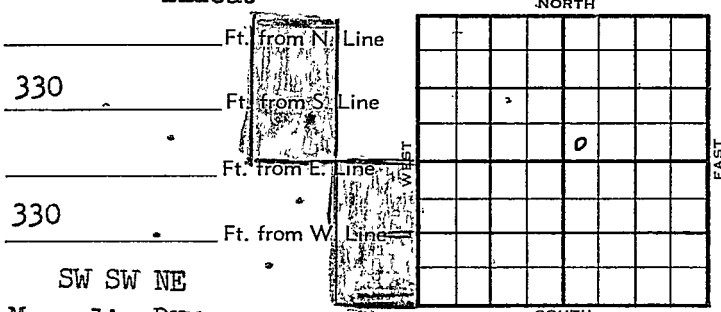

SW SW NE

Magnolia DHM

MCPC has NE $\frac{1}{4}$ & E $\frac{1}{2}$ SE $\frac{1}{4}$ Sec. 9


1954	ELEVATION	REPORT
	1507'	
10/20	Spud 10-16-54 8" @ 150 Drlg. 1340'	
10/29	KC 3388' Miss 4149 DST 4150-70, gas in 1 $\frac{1}{2}$ min, gauge 2,200,000 CFG in 7 min, open 1 hr, 1,540,000 CFG, 90' OCM. IF 335# FFP 255# BHP 1306# DST 4170-90, gas to surface in 40 min open 1 hr rec 130' gassy mud, slight oil cut. IFP 40# FFP 53# BHP 655# DST 4190-4210, open 1 hr weak blow, rec 70' mud. IFP 40# FFP 53# BHP 241# TD 4240' 5 $\frac{1}{2}$ " @ 4240 WOCT (Ltr-Gilstrap)	
11/24	CO to 4180 114/ 4153-72, B/ 10 ghocm 800,000 cfg, blew 12 hr., decreased 200 M-A, frac. F/L, F/ 20 bo 24 hr., 1,000,000 cfg, F 1 $\frac{1}{2}$ boph 750,000 cfg, frac, F/2 bf 25% wtr per hr 16 hr., testing. (Sct.Ltr.)	
12/2	F/9.6 BO 6.4 BW 24 hrs. Est 250,000 CFG. (Ltr-Gilstrap)	
12/16	D & A	"

OVER

1954
12/15

Spud 10-16-54 D & A TD 4240'
8" @ 150 KC 3388 Miss 4149
DST 4150-70 open 1 hr gas to surface
1½ min, 2,200,000 CFG 1306#
DST 4170-90 op 1 hr, rec 130' gassy
mud. 655#
DST 4190-4210 open 1 hr rec 70' mud
241# TD 4240' 5" @ 4240 CO to
4180'. 114/4153-72 B/10 gal. HOCM
800,000 CFG 200 M-A frac.
F/20 BO 1,000,000 CFG F/½ BOPH
750,000 CFG frac. F/2 BF 25%
wtr PH 16 hr. F/9.6 BO 6.4 BW
24 hrs. 250,000 CFG.
D & A

ABANDONED

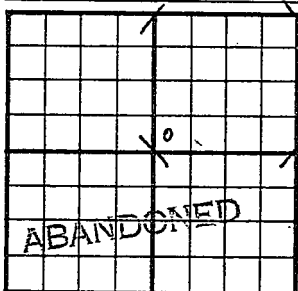County Kingman State KansasSec. 10 (Blk.) 30 (Sur.) 8W Map No.Operator Beardmore Drlg.Well No. 1 Farm MorrisElev. 1507 Location SW SW NE330 Ft. From S Line NE330 Ft. From W Line Quarter

1st. Report

Completion DEC 15 1954Remarks Wildcat

Co. tools

Spudding Date 10-16-54Drlg. Data D & A TD 42408" @ 150 KC 3388 Miss. 4149DST 4150-70 open 1 hr. gas to surface1½ min. 2,200,000 cfg 1306# DST 4170-90 open 1 hr. Rec. 130' gassy mud 655#DST 4190-4210 open 1 hr. Rec. 70' mud241# TD 4240 5" @ 4240 CO to 4180114/ 4153-72 B/ 10 gal. hoem 800,000 cfg200 M-A frac F/ 20 bo 1,000,000 cfgF/ ½ boph 750,000 cfg fracF/ 2 bf 25% wtr ph 16 hr. F/ 9.6 bo6.4 bw 24 hr. 250,000 cfgD & A

FABEN G'LTRAP

Scout Cards	mm
Land Wall Map	
Tracings	
France Map	
Pierce Map	
Misc.	

DEC 23 1954

Drig. Date

County Kingman State KansasSec. 10 (Blk. 30) (Sur. 8W) Map No.Operator Beardmore Drlg.Well No. 1 Farm MorrisElev. Location SW SW NE330 Ft. From S Line NE330 Ft. From W Line Quarter1st. Report OCT 20 1954

Completion

~~MCPC has NE $\frac{1}{4}$ & E-SE $\frac{1}{4}$ - 9~~Remarks Magnolia - DHMCo. toolsSpudding Date 10-16-54Drlg. Data Wildcat8" @ 150 drlg* 1340

FABEN GILSTRAP

OCT 22 1954

Scout Cards	MM
Land Small Map	
Land Wall Map	3
Tracings	
France Map	
Pierce Map	
Misc.	

Drig. Data