KANSAS


FORM 51 25M 3-49 PETROL

Haskell

Section 10 Township 30 Range 33W

Well No. #1 Gheen

Company Panhandle Eastern

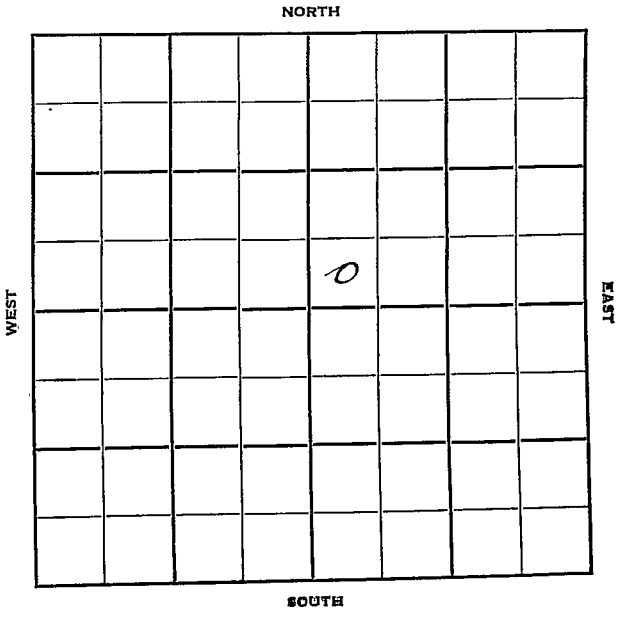

FORM 252-B
10M 9-49 PETROL

KANSAS Haskell

Sec. 10 Twp. 30 R. 33-W

Well No. #1 Gheen Farm

Panhandle Eastern Company

Burris Contractor

Hugoton Pool


____ Ft. from N. Line

330 Ft. from S. Line

____ Ft. from E. Line

330 Ft. from W. Line

SW SW NE

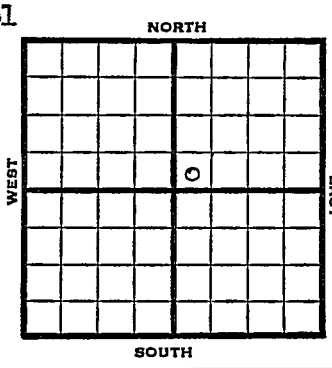

1950	Elev 2950 REPORT
3/22	Spud 3-17-50 10"@ 620 Drlg 1380'
10/18	10" @ 620 7" @ 2609 TD 2752 161' 5½" liner 3000 A PB 2739 Her 2618 Krider 2646-2700 Win 2710-47 open flow 5,391,000 gas Completed
	COMPLETED

Form 26 200 Bks. 11-49 Petrol Kansas Hugoton Pool

Map No. ____ Sec. 10 Twp. 30 R. 33W


Well No. 1 Gheen

Panhandle Eastern Company

Contractor

SW SW NE

SECTION PLAT

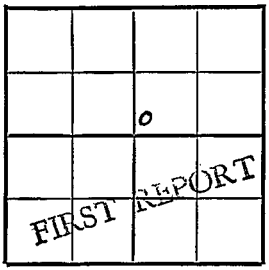

____ Ft. from N. Line

330 Ft. from S. Line

____ Ft. from E. Line

330 Ft. from W. Line

Haskell County

Location

Rig up

Drilling and Remarks:

Spud 3-17-50

10" @ 620

drlg. 1380

RECORD

Cased ____ in., ____ ft.

Sand

Gas

Oil

Total Depth

PRODUCTION

1st 24 hrs. Nat.

1st 24 hrs. after shot

Gas ____ Cu. Ft.

Dry Hole

Abandoned

Date

MAR 22 1950 19

J. E. TYRA Scout

FORM 275 FOR SALE BY KANSAS BLUE PRINT CO.


County Haskell State Kansas

Sec. 10 (Blk. Twp.) 30 (Sur. Rge.) 33W Map No.

Operator Panhandle Eastern

Well No. 1 Farm Gheen

Elev. 2950 Location SW SW NE

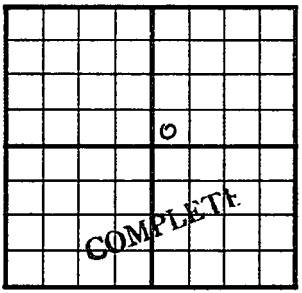

330 Ft. From S Line NE

330 Ft. From W Line Quarter

Ist. Report

Completion OCT 18 1950

Remarks Hugoton Pool

Burris - Contr.

Spudding Date 3-17-50

Drlg. Data Gas well TD 2752

10" @ 620 7" @ 2609 TD 2752

161' 5½" liner 3000 A PB 2739

Her. 2618 Krider 2646-2700 Win. 2710-47

Open flow.

5,391,000 gas

J. E. TYRA