
Kingman

KANSAS

SECTION 10 TOWNSHIP 30 RANGE 7W

WELL NO. #1 F. N. Cheatum

COMPANY Pure Oil

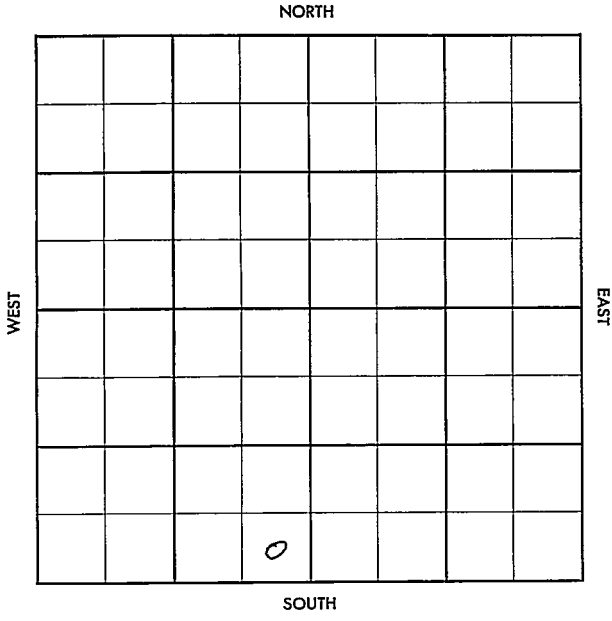

FORM 504-3 SUNRAY

Kingman KANSAS

SEC.	TWP.	R.
10	30	7W

WELL NO.
#1 F.N. Cheatum FARM

COMPANY
Pure Oil

CONTRACTOR
Gabbert-Jones

W.Reida


_____ Ft. from N. Line

_____ Ft. from S. Line

_____ Ft. from E. Line

_____ Ft. from W. Line

SE SE SW

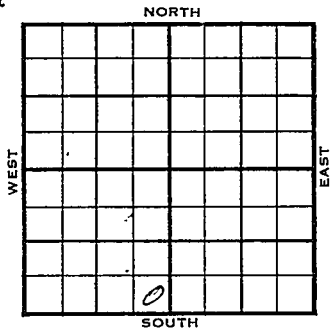

1956	ELEVATION 1437'	REPORT
4-11	Location	
5-2	Comm. 4-12-56 8 5/8" @ 167 w/200 DST 4097-4118 op 1 hr. ga. 550 MCF rec. 120' GCM,BHP 1545/20" SLM 4118=4109 4½" @ 4109 w/250 CO 56/ 4095-4109 Frac ##### 5x5 ga 3,540 MCF& FTP 100# FCP 500# H. 3010 Dg. sh.- 3090 L. 3250 KC 3566 3650 M. 4104 4095 TD 4109' 3250 1437 1813	
	COMPLETED 4104 4095 1437 2658	

DX-78

FORM 513 SUNRAY

County Kinkman Elev.

Sec. 10 Twp. 30 Rge. 7W

Company Pure Oil

Farm Name F. N. Cheatum No. 1

TOPS	DEPTH	LOG	DATUM
Anh.			
Tp.			
H.			
Tr.			
Dg.			
Bl.			
L.			
K.C.			
B.K.C.			
Ce.			
C.			
M.			
M.			
K.			
Mz.			
Mo.			
V.			
S.			
S.			
A			
R.			
P€.			
G.			
T.D.			

Loc. in Sec. SE SE SW

Geol.

Contr. Gabbert-Jones

Pool W. Reida



Date Comm.

Location

APR 1 1955

Co. Lse. No. Sec. T. R.

FORM 513 SUNRAY

County Kingman Elev. 1437

Sec. 10 Twp. 30 Rge. 7W

Company Pure Oil

Farm Name F. N. Cheatum No. 1

TOPS	DEPTH	LOG	DATUM
Anh.			
Tp.			
H.		3010	
Tr.			
Dg. Sh		3090	1653
Bl.			
L.		3250	1813
K.C.	3566	3650	2213
B.K.C.			
Ce.			
C.			
M.	4104	4095	2658
M.			
K.			
Mz.			
Mq.			
V.			
S.			
S.			
A			
R.			
P€.			
G.			
T.D.	4109		

Loc. in Sec. SE SE SW

Geol.

Contr. Gabbert-Jones

Pool W. Reida

COMPLETE

MAY 2 1956

Date Comm.

Location APR 18 56 4-12-56 8 5/8 167

/200 Ø 1610 APR 23 56 Ø 4116 MAY 2 56

DST 4097-4118 1hr gg 550 MCF

rec. 120' GCM BHP 1545/20"

SLM 4118 = 4109 4½ @ 4109/

250 CO 56/4095-4113 /1# FVAC

5X5 gg 3,540 MCF FTP 100 FCP

500#

Co. Lse. No. Sec. T. R.