

SECTION 11 TOWNSHIP 30 RANGE 19WWELL NO. #1 Williamson UnitCOMPANY Graham-Michaelis & Pure Oil

SE
G NW SE

NORTH

SOUTH

EAST

WEST


Kiowa

KANSAS

SEC.	TWP.	R.
11	30 S	19 W

WELL NO.

1 Williamson Unit

FARM

COMPANY

Graham-Michaelis & Pure Oil

CONTRACTOR

Graham-Michaelis Tools

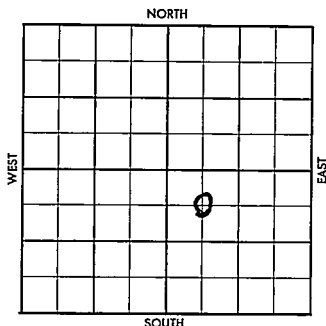
Wildcat

_____ FT. FROM N. LINE

_____ FT. FROM S. LINE

_____ FT. FROM E. LINE

_____ FT. FROM W. LINE

SE
NW SE

SDX-1/2 Mile

1957

ELEVATION

REPORT

5/15

Comm. 5-12-57
8" @ 566/280 WOC

WILDCAT

County KLING Elev. _____
 Sec. 14 Twp. 30 Rge. 19W
 Company Graham-Michaelis & Pure Oil
 Farm Name Williamson Unit No. 1

TOPS

DEPTH

LOG

DATUM

Loc. in Sec.

Anh.

C NW SE

Tp.

H.

Tr.

Dg.

BL.

L.

K.C.

B.K.C.

Ce.

C.

M.

M.

K.

Mz.

Mo.

V.

S.

S.

A.

R.

PE.

G.

T.D.

Geol.

Contr. Graham-Michaelis Tool

Pool

Wildcat

FIRST REPORT

1/2 mile

0

MAY 15 57

Date Comm. 5-12-578" @ 566/280, WOC

2/5

X

CORRECTION

FORM 513 SUNRAY

County Xiowa Elev. 2252
 Sec. 11 Twp. 30 Rge. 19W
 Company Graham-Michaelis & Pure Oil
 Farm Name Williamson Unit No. 1

TOPS	DEPTH	LOG	DATUM	Loc in Sec
	3515			<u>G. M. SE</u>
	3700			<u>SE</u>
	4002			
	4225			
Dg.				
Bl.				
L.	4408			Geol.
K.C.				
B.K.C.	4827			Contr. Graham-
Ce. <u>Lenax</u>	4849			<u>Michaelis To</u>
C. <u>Altmore</u>	4876			
M. <u>Pawn</u>	4926			Pool
M. <u>Etsc</u>	4950			
K. <u>ce</u>	4963			<u>Wildcat</u>
Mz. <u>MISS</u>	5028			
Mo.				
V.				
S.				
S.				
A.				
R.				
Pe.				
G.				
T.D.	5130			

ABANDONED

JUN 5 57

Date Comm. 5-12-57

8" @ 566/280, WOC MAY 22 '57 3700 MAY 22 '57
 DST 4672-4702 30" rec 22'
 Md BHP 1500/20" DP 4926
 JUN 5 '57 DST 5035-52 op 1 hr
 rec 95' Md BHP 775/20"
 DST 5054-5070 op 20" rec
 40' Md BHP 550/20" DST
 5072-94 1 hr. rec 150' Md
 BHP 980/20 DST Acid Tool

FORM 513-1 SUNRAY

5037-5130 1 hr 140' Acid
Wt BHP 260/20"

DFA