KANSAS

Form 51—5M—7-40—Palace


Grant

Section 11 Township 30 Range 35-W

Well No. #1 ~~Harper~~ Lighty

Company United Production

Wildcat

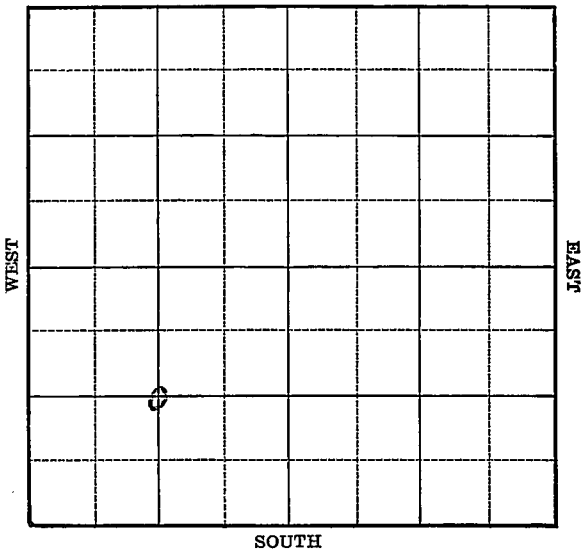


FORM 252-A 5M 7-40 PETROL KANSAS Grant

Sec. 11 Twp. 30 R. 35-W

Well No. #1 ~~Harper~~ Lighty Farm

United Production Company

(Wildcat)

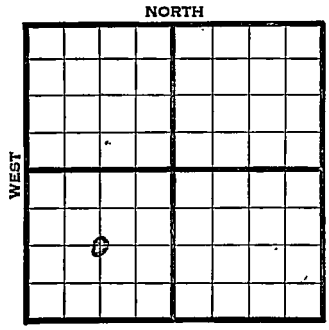

_____ Ft. from N. Line

1320 Ft. from S. Line

_____ Ft. from E. Line

1320 Ft. from W. Line

Elev. 3011

1940	REPORT
10/2	Rotary.
10/10	"
10/17	10" - 556' Drlg. 1725'
10/24	" " " "
10/31	7" - 2513' S. Gas 2535'
	Drlg. 2600'
11/7	" "
11/13	Herrington 2517'
	7" - 2513'
	T.D. 2705'
	800 acid.
	7½ M gas.
	COMPLETED

Form 26—200 Bks.—1-40—Palace Grant KANSAS

Map No. NM Sec. 11 Twp. 30 R. 35W

Well No. 1 Harper

United Production Company

Contractor

FIRST REPORT

C SW

Ft. from N. Line


1320 Ft. from S. Line

Ft. from E. Line

1320 Ft. from W. Line

WILDCAT

SECTION PLAT

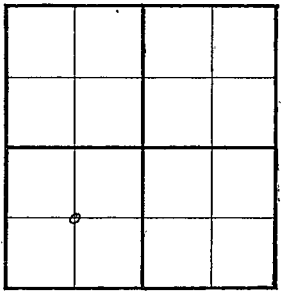

Location

Rig up

Drilling and Remarks:

Rotary

RECORD

Cased in., ft.

Sand

Gas

Oil

Total Depth

PRODUCTION

1st 24 hrs. Nat.

1st 24 hrs. after shot

Gas Cu. Ft.


Dry Hole

Abandoned

Date

OCT 2 1940 19

S. J. LEWIS Scout

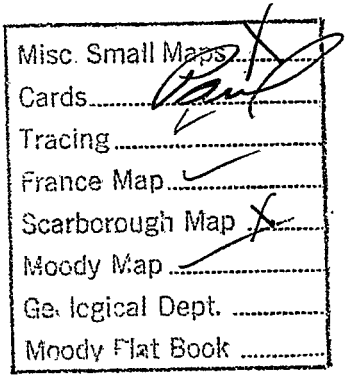
Misc. Small Maps
Cards
Tracing
France Map
Scarborough Map
Moody Map
Geological Dept.
Moody Flat Book

Form 26—200 Bks.—1-40—Palace Grant KANSAS

Map No. NM Sec. 11 Twp. 30 R. 35W

Well No. 1 Lighty

United Production Company

CORRECTION Contractor

C SW

_____ Ft. from N. Line


1320 Ft. from S. Line

_____ Ft. from E. Line

1320 Ft. from W. Line

WILDCAT

SECTION PLAT

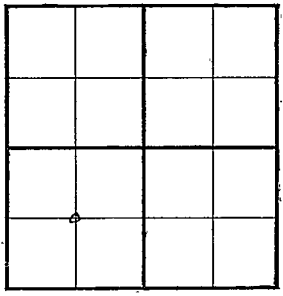

Location _____

Rig up _____

Drilling and Remarks:

Reported as

#1 Harper

RECORD

Cased _____ in., _____ ft.

Sand _____

Gas _____

Oil _____

Total Depth _____

PRODUCTION

1st 24 hrs. Nat. _____

1st 24 hrs. after shot _____

Gas _____ Cu. Ft.


Dry Hole _____

Abandoned _____

Date

OCT 16 1940 19____

S. J. LEWIS Scout

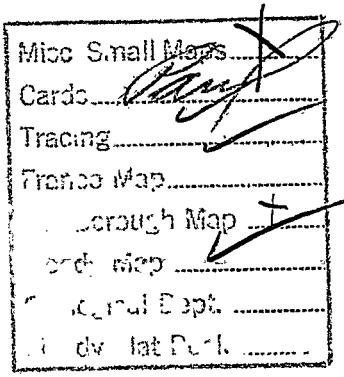
Misc Small Maps
Cards
Tracing

Form 26—200 Bks.—1-40—Palace Grant KANSAS

Map No. NM Sec. 11 Twp. 30 R. 35W

Well No. 1 Lighty

United Production Company

Contractor

COMPLETED

C SW

_____ Ft. from N. Line


1320 Ft. from S. Line

_____ Ft. from E. Line

1320 Ft. from W. Line

WILDCAT

SECTION PLAT

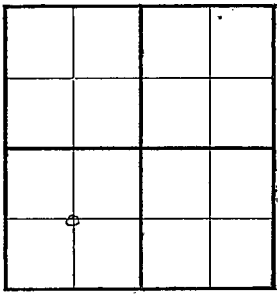

Location _____

Rig up _____

Drilling and Remarks:

Herrington 2517
7" @ 2513
8000 acid
7½ M Gas.

RECORD

Cased _____ in., _____ ft.

Sand _____

Gas _____

Oil _____

Total Depth 2705-

PRODUCTION

1st 24 hrs. Nat. _____

1st 24 hrs. after shot _____

Gas _____ Cu. Ft.


Dry Hole _____

Abandoned _____

Date

NOV 13 1940 19____

S. J. LEWIS Scout

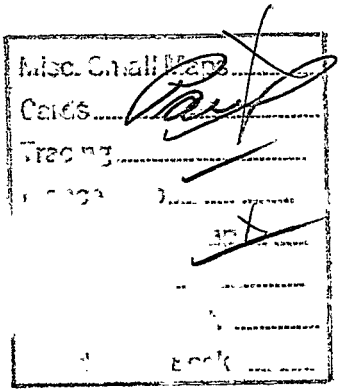
Cards
Trea ng