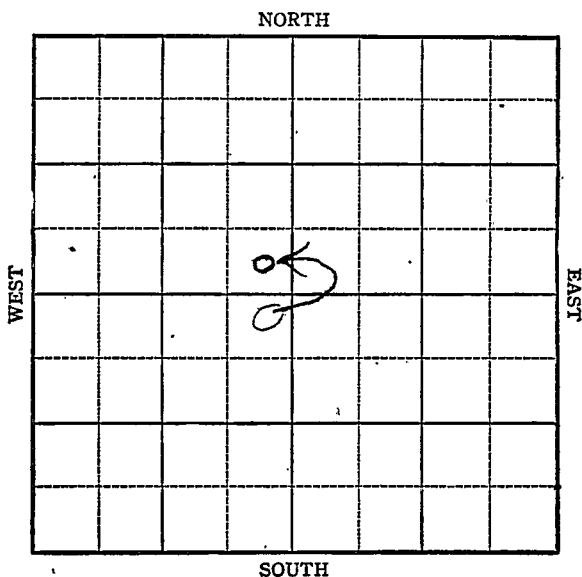


KANSAS Haskell County

Section 11 Township 30 Range 34WWell No. #1 Siddons #5 HuxmanCompany United Prod.

KANSAS Haskell County

Sec. 11 Twp. 30 R. 34W

Well No. ~~#1 Siddens~~ #5 Huxman Farm

United Prod. Company
Hugoton


~~100~~ Ft. from N. Line

~~100~~ Ft. from S. Line

~~100~~ Ft. from E. Line

~~100~~ Ft. from W. Line

~~NE SW~~ SE NW Elev. 2975

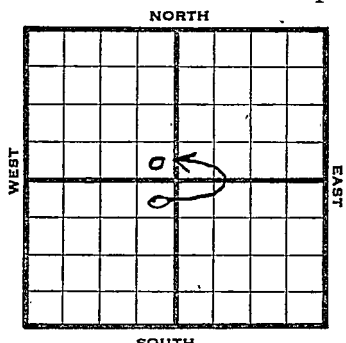

1944 REPORT

10/18	Location
10/25	"
11/1	"
11/8	"
11/16	"
11/24	RUR
11/29	Drlg. 220
12/6	Derrick Never spudded
12/14	RUR
12/21	10" @ 660' WOC
12/29	" " " "
1945	
1/3	Drlg 1350
1/10	Drlg 1510
1/17	7" @ 2540
	TD 2740 248' of 5" perf liner @ 2740
1/26	" " " " " "
1/31	" " " " " "
2/7	" " " " " "
2/14	" " " " " "
2/21	8000 Acid
2/28	" "

OVER

1945

3/7 7" @ 2540
248' of 5" Perf. Liner @ 2740
8000 acid
TD 2740
13,632,000 Gas.

COMPLETED

KANSAS Pool Name HugotonMap No. V/M Sec. 11 Twp. 30 R. 34WWell No. 1 SiddensUnited Prod CompanyFIRST REPORT Contractor

NE SW

SECTION PLAT

100 Ft. from N. Line Ft. from S. Line100 Ft. from E. Line Ft. from W. Line

	a		

Haskell

RECORD

Location XCased in., ft.Sand Gas Oil Total Depth Rig up

Drilling and Remarks:

PRODUCTION

1st 24 hrs. Nat. 1st 24 hrs. after shot Gas Cu. Ft.Dry Hole Abandoned

Date

OCT 1 8 1944

19

S. J. LEWIS Scout

no wall map


Misc. Small Maps	<i>Leid No 7 a</i>
Cards	<i>Leid</i>
Tracing	
France Map	
Scarborough Map	<i>Leid</i>
Moody Map	
Geological Dept.	
Moody Plat Book	

Pool Name HugotonMap No. N/M Sec. 11 Twp. 30 20 R. 34 WWell No. 5 HuxmanUnited Prod. Company**CORRECTION**

Contractor

SE NW

SECTION FLAT

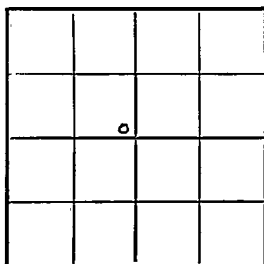 Ft. from N. Line100 Ft. from S. Line100 Ft. from E. Line Ft. from W. LineHaskellLocation Rig up

Drilling and Remarks:

Reported
#1 Siddens

NE SW

RECORD

Cased in., ft.Sand Gas Oil Total Depth

PRODUCTION

1st 24 hrs. Nat. 1st 24 hrs. after shot Gas Cu. Ft.Dry Hole Abandoned

Date

OCT 25 1944 19S. J. LEWIS Scout


no wall map

Misc. Small Maps	<i>Reid no map</i>
Cards	<i>Putty</i>
Tracing	<i>f</i>
France Map	
Scot. rough Map	<i>Reid</i>
Aloud, Map	
Cæological Dept.	
Acody Print Book	

Pool Name HugotonMap No. Map Sec. 11 Twp. 30 R. 34WWell No. 5 HuxmanUnited Prod CompanyCOMPLETED Contractor

SE NW

SECTION PLAT

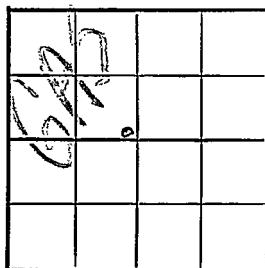 Ft. from N. Line100 Ft. from S. Line100 Ft. from E. Line Ft. from W. Line

Haskell County

Location Rig up

Drilling and Remarks:

7' @ 2540245' by 3" Perf. Liner@ 27408000 acq'd13,632,000 Gas

RECORD

Cased in., ft.Sand Gas Oil Total Depth 2740

PRODUCTION

1st 24 hrs. Nat. 1st 24 hrs. after shot Gas Cu. Ft.Dry Hole Abandoned

Date

MAR 7 1945 19S. J. LEWIS Scout

no wall map

i use Small Maps	<i>LP</i>
Cards	<i>Petty</i>
Tracing	
France Map	
Scarborough Map	<i>LP</i>
Pierce Map	
Geological Dept.	
Pierce Port B.	