

KANSAS


FORM 51 5M PETROL

Barber

Section 12 Township 30 Range 12-W

Well No. #1 Mary Hull

Company Shell

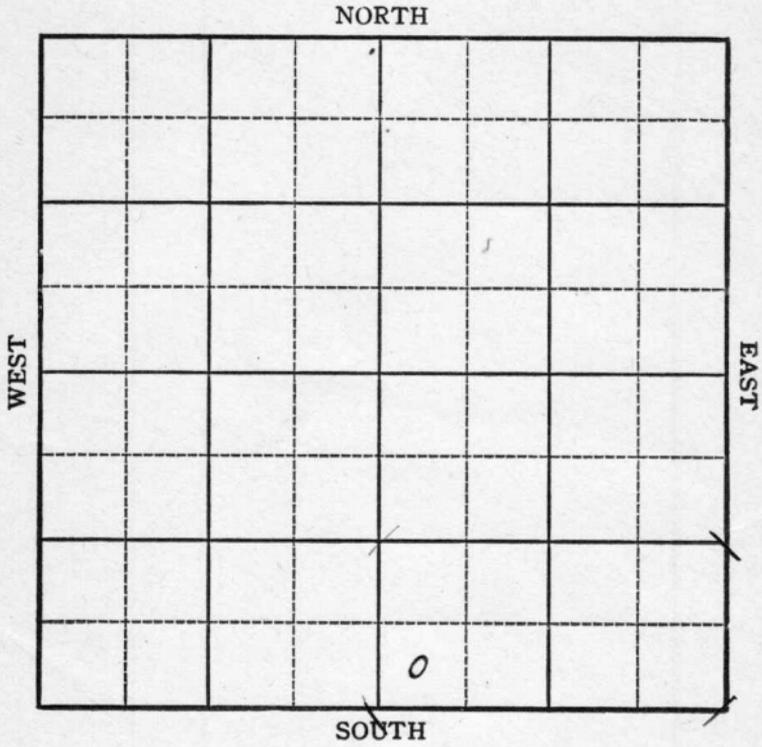

Sec. 12 Twp. 30 R. 12-W

Well No. #1 Mary Hull Farm

Shell Company


_____ Ft. from N. Line

330 Ft. from S. Line

_____ Ft. from E. Line

330 Ft. from W. Line

Elev. 1851

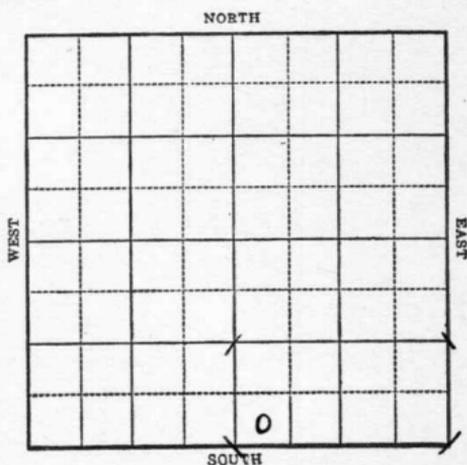

1943

R E P O R T

9/8

Location

9/15

Surface hole

9/22

10" @ 968'
Drlg. 1810'

9/29

Drlg. 3205'

10/6

Topeka 3375
Drlg. 4153'

10/13

Lans 3920
Miss 4384
Drlg. 4490

10/20

Kind 4420
Simp 4679

Arb 4804
Drlg. 4810

10/27

Arb 4792 corrected
T.D. 4865
No shows.

11/3

Arb 4792 Corrected
No shows
T.D. 4865'

ABANDONED

Barber

KANSAS

Map No. 54 Sec. 12 Twp. 30 R. 12W

Well No. 1 Mary Hull

Shell


Company

FIRST REPORT

Contractor

SW SE

SECTION PLAT

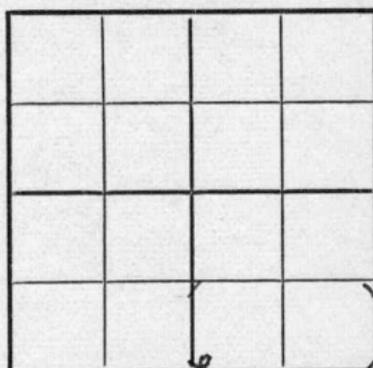

Ft. from N. Line

330 Ft. from S. Line

Ft. from E. Line

330 Ft. from W. Line

Wild cat

Location X

Rig up _____

Drilling and Remarks:

RECORD

Cased _____ in., _____ ft.

Sand _____

Gas _____

Oil _____

Total Depth _____

PRODUCTION

1st 24 hrs. Nat. _____

1st 24 hrs. after shot _____

Gas _____ Cu. Ft.

Dry Hole _____

Abandoned _____

Date

SEP 8 1943

19

S. J. LEWIS

Scout

KANSAS

Map No. _____ Sec. 12 Twp. 30 R. 12W

Well No. 1 Mary Hull

Shell Company

ABANDONED Contractor

SW SE

SECTION PLAT

_____ Ft. from N. Line

330 Ft. from S. Line

_____ Ft. from E. Line

330 Ft. from W. Line

		0	

Wildcat

Location _____

Rig up _____

Drilling and Remarks:

Cert 4792 corrected

No show

RECORD

Cased _____ in., _____ ft.

Sand _____

Gas _____

Oil _____

Total Depth 4865

PRODUCTION

1st 24 hrs. Nat. _____

1st 24 hrs. after shot _____

Gas _____ Cu. Ft.

Dry Hole _____

Abandoned _____

Date

NOV 3 1943 19

S. J. LEWIS Scout