
Kingman KANSAS

SECTION 12 TOWNSHIP 30S RANGE 8W

WELL NO. #2 Young

COMPANY Murphey Oil

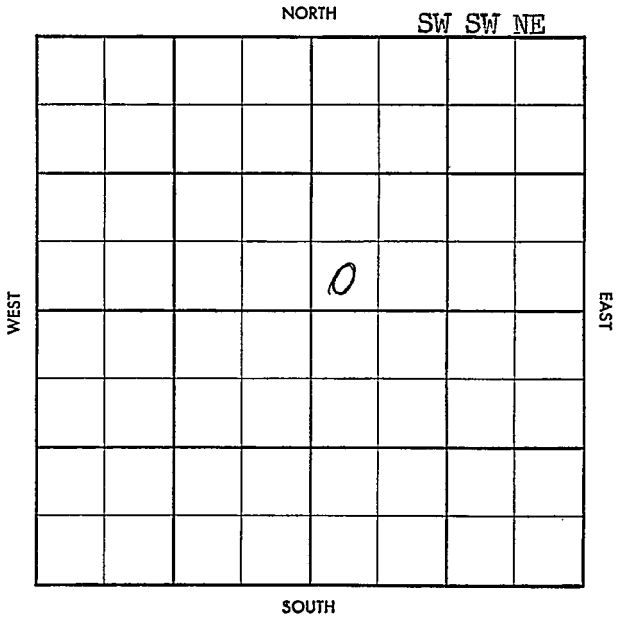

FORM 504-3 SUNRAY

S-513-A

CO. Kingman ELEV. 1523

SEC. 12 TWP. 30 RGE. 8W

COMPANY Murphey Oil NO. 2

FARM Young

LOC. SW SW NE

DEC 4 57

FIRST REPORT

GEOL.

CONTR. Barbour

POOL Spivey-Grabs

SPUD 11-27-57

10" @ 283/295

drlg. 2230

CO. LSE. NO. SEC. TWP. RGE.

S-513-A

CO. Kingman ELEV. 1523 DF

SEC. 12 TWP. 30 RGE. 8W

COMPANY Murphey Oil NO. 2

ABANDONED

DEC 18 '57

FARM Young

LOC. SW SW NE

GEOL.

CONTR. Barbour

POOL Spivey-Grabs

SPUD 11-27-57

10" @ 283/295

drlg. 2230

M Chat 4153

DST 4156-83

60" g/5'

ga 82 mcf 17c'

gcm BHP 1685-1570 DST

4183-4205 60" 85' Hg c6

50cm BHP 1390-780/20"

RTD 4350 SJ Tops

L 3392 M Chat 4153 ML1

4198 -1675 -1539 2630

D & A

COMP.

LSE.

NO.

SEC.

TWP.

RGE.