

O. W. P. B

Kingman

KANSAS

12

30

8W

SECTION _____ TOWNSHIP _____ RANGE _____

#1 Wallace Young

WELL NO. _____


Amerada Petr.

COMPANY _____

SW

NORTH

~~SW~~ NE SW

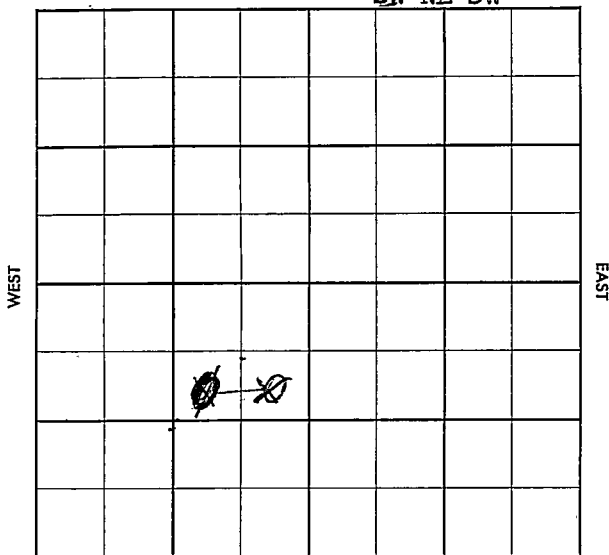

SOUTH

County Kingman Elev. _____
 Sec. 12 Twp. 30 Rge. SW
 Company Amerada Petroleum
 FarmName Wallace Young No. 1

TOPS	DEPTH	LOG	DATUM	Loc. in Sec.
Anh.				SW NE SW
Tr.				
H.				
Tr.				
Dg.				
BL.				
L.				Geol. _____
K.C.				Contr. _____
B.K.C.				D & M Tools
Ce.				Pool _____
C.				Spivey-Grabs
M.				
M.				
K.				
Mz.				
Me.				
V.				
S.				
S.				
A.				
R.				
PE.				
G.				
T.D.				

FIRST REPORT
 H. M. K.
 FEB 20 '57

Date Comm. 2-14-57
8" @ 262/225 Drlg. 2550

~~Spivey~~
O.W.P.B.

S-513-A

CO. Kingman ELEV. _____
SEC. 12 TWP. 30 RGE. 8W
COMPANY Amerada NO. 1

FARM W. Young
LOC. SE NE SW

(O.W.P.B.)

GEOL. O.W.P.R.
CONTR. _____
POOL Spivey
SPUD Old Info. Miss
4114, Miss land 4160, OTD
4223, 5" @ 4221, oil well
NEW INFO. Set BP 4160
PB 4152 84/4115-36, 250
MA, A-Petro-frac (20/20/
Flo 20/64" ch, 3,474,000

cfg 17 hrs, IFTP 740 FFEP 900, IFCP 920,
FFCP 1000 SI WOP

CO.
USE.
D.
NO.
SEC.
TWP.
RGE.

420/20 DST 4181-4223 cr)

2 hrs 185' 50 CM 265/20"

5 1/2 @ 4221/200 RUCT UNIT 3 54

CO 4218 PR 224 / 4170 - 4216

500 MCA \$ 16 BF 2

H. Fee 4/4 \$ 26 BO + 69 BW / 7 hrs

\$ 39 BO + 125 BW / 24 hrs \$ 16 BO

61 BW / 16 hrs T+R UNIT 20 57

P. 18 BO + 90 BW in 24 hrs

CORRECTION

S-513-A

CO. ~~Kingman~~ ELEV. _____

SEC. ~~12~~ TWP. ~~30~~ RGE. ~~8.~~

COMPANY ~~Alexada~~ NO. ~~1~~

SW NESW

COMPLETE
NOV 6 '57

FARM _____

LOC. ~~SE NE SW~~

GEOL. _____

CONTR. _____

POOL ~~Spivey~~

SPUD ~~Old Info. Miss~~

~~414, Miss Tank. 410,~~

~~422, 5" & 4221, old well~~

~~NEW INFO. Set BF 210~~

~~FB 4152 34/4115-30, 250~~

~~LA A-Retro-proc in '50~~

~~flo 20' (4" ch, 5, 7, 10)~~

of 17 hrs, IFCP 740 FFB 9.0, IFCP 02

FFCF 1000 SI MP

delivered 3, 688 MCF Pd RCP 942

SICP 1391 SITP 1380

2 5/64" CHK NOV 6 '57

CO.

USE.

CT

NO.

SEC.

TWP.

RGE.