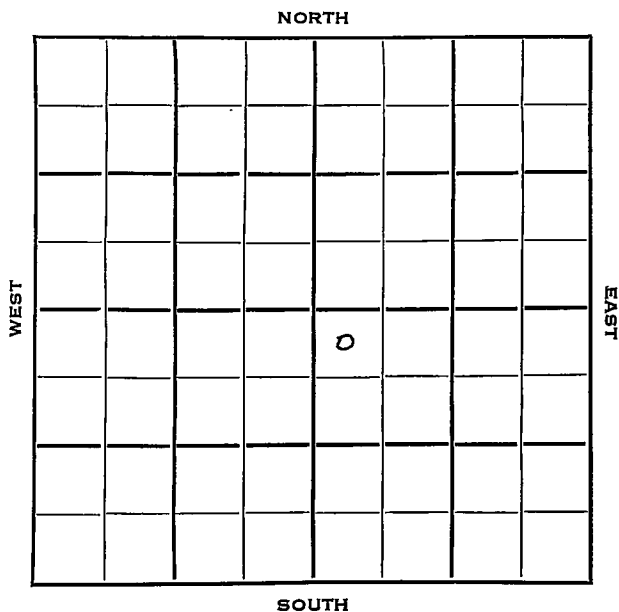


Section 12 Township 30 Range 33WWell No. #1 McCoyCompany Huber Corporation

Haskell

KANSAS ✓

Sec. 12 Twp. 30 R. 33W

Well No. #1 McCoy Farm

Huber Corp. Company

Contractor


150 Ft. from N. Line

Ft. from S. Line

Ft. from E. Line

150 Ft. from W. Line

NW SE

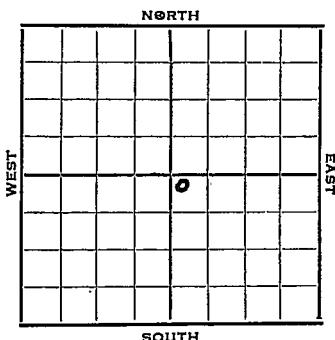

L953 Elev. 2932' REPORT

2/25 Spud 2-22-53
8" @ 556
Drlg. 1935

3/12 Her 2621, Up Kr 2646, Win 2719
RTD 2725
5" @ 2725
CO 2719
60/2658-68, 72/2694-2706
St-frac
DD 2748
40/2658-68, 48/2694-2706,
30/2738-48, 4000A

3/19 NR

3/26 NR

4/1 Spud 2-22-53 Gas well TD 2748
8" @ 556 Her. 2621 Kri. 2646
Win 2717 TD 2725 5" @ 2725
CO to 2719' 60/2658-68 72/2694-2706
sy-frac. DD 2748 40/2658-68 48/2694-2706
2694-2706 30/2738-48 4000 A
Comp. 1,350,000 gas.

COMPLETED

County Haskell State Kansas
 Sec. 12 (Blk.) 30 (Sur.) 33W Map No.
 Operator Huber Corp.
 Well No. 1 Farm McCoy
 Elev. Location NW SE




150 Ft. From N Line SE
150 Ft. From W Line Quarter
 1st. Report FEB 25 1953
 Completion
 Remarks
 Spudding Date 2-22-53

Drlg. Data

8" @ 556 drlg. 1935

J. G. McGEHEE

County Haskell State Kansas
 Sec. 12 (Blk. 30 (Sur. 33W Map No.
 (Twp.) (Rge.)
 Operator Huber Corp.
 Well No. 1 Farm McCoy
 Elev. 2932 Location NW SE

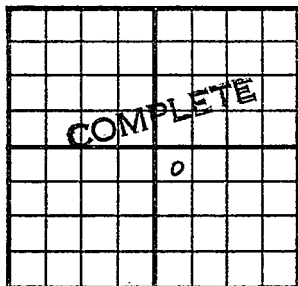

150 Ft. From N Line SE
150 Ft. From W Line Quarter

1st. Report

Completion APR 1 1953

Remarks

Spudding Date 2-22-53

Drig. Data Gas well TD 2748
8" @ 556 Her. 2621 Kri. 2646
Win. 2717 TD 2725 5" @ 2725 CO to 2719
60/ 2658-68 72/ 2694-2706 st-frac
DD 2748 40/ 2658-68 48/ 2694-2706
30/ 2738-48 4000 A
Comp. 1,350,000 gas

J. G. McGEHEE