


DX 78-1

Haskell KANSAS

Section 12 Township 30 Range 3 2W

Well No. 1 Marshall

Company Wm. Graham

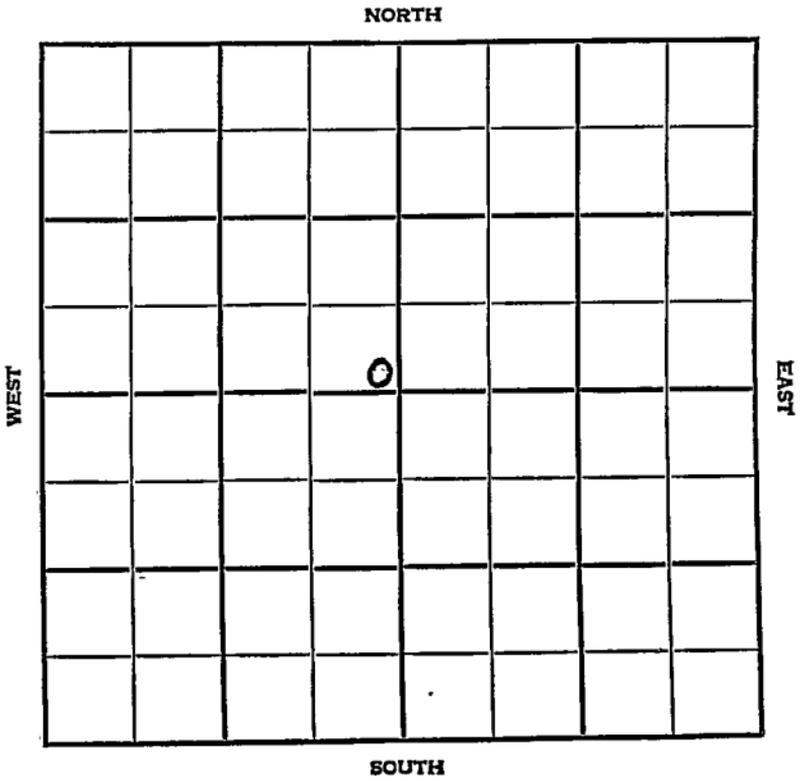

| | | |
|------|------|-----|
| SEC. | TWP. | R. |
| 12 | 30 | 32W |

WELL NO. #1 Marshall FARM

COMPANY Wm. Graham

CONTRACTOR Co. Tools.


Hugoton Pool

_____ Ft. from N. Line

100 _____ Ft. from S. Line

100 _____ Ft. from E. Line

_____ Ft. from W. Line

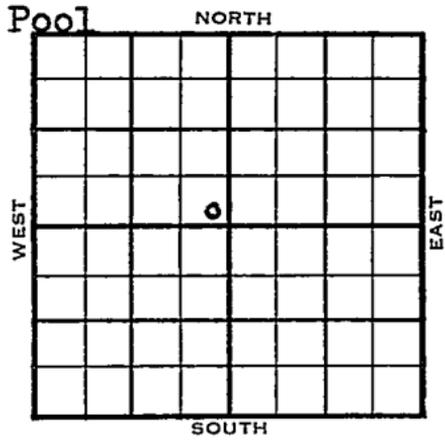

SE SE NW
CSO F/O

| | | |
|------|--------------------|--------|
| 1954 | ELEVATION 2868' | REPORT |
|------|--------------------|--------|

10/27 Spud 10-22-54
8" @ 533'
Drlg. 2020'

11/23 Spud 10-22-54
Gas Well
TD 2745'
8" @ 533'
TD 2745'
5" @ 2744'
48/ 2668-80 80/ 2704-24 5000 A
dol-frac. 5000 A dolofrac.
3,958,000 cfg. Kri 2668'
Comp 11,600,000 cfgpd. 417#

COMPLETED

