FORM 51 25M 8-50 WESTERN


KANSAS

Grant

Section 12 Township 30 Range 37-W

Well No. #1-12 Hoehn

Company Hugoton Prod.

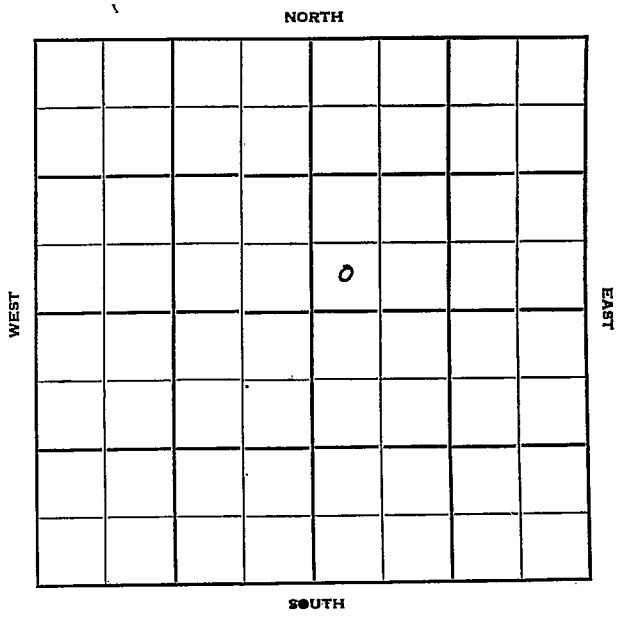

FORM 252-B
10M 11-50 PETROL

Grant KANSAS

Sec. 12 Twp. 30 R. 37W

Well No. #1-12 Hoehn Farm

Hugoton Prod. Company

Contractor


2345' Ft. from N. Line

Ft. from S. Line

2433' Ft. from E. Line

Ft. from W. Line

SW NE

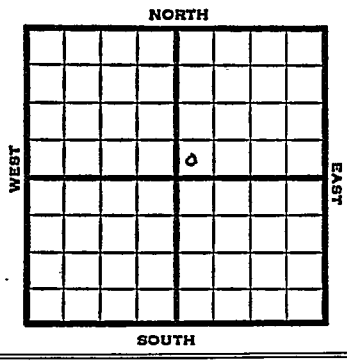

1951	Elev. 3070 REPORT
1/3	Spud 12-12-50 10" @ 580 TD 2705 7" @ 2443 Set 284' of 5" liner
2/7	Spud 12-12-50 Gas well TD 2705 10" @580 7" @2443 TD 2705 Hol. 2423 Her. 2464 Krider 2476 Win. 2546-85 Towanda 2615 16000 A Comp. 15,950,000 gas 408# **COMPLETED**

FORM 275 FOR SALE BY KANSAS BLUE PRINT CO.


County Grant State Kansas

Sec. 12 (Blk. Twp.) 30 (Sur. Rge.) 37W Map No.

Operator Hugoton Prod.

Well No. 1-12 Farm Hoehn

Elev. Location SW NE

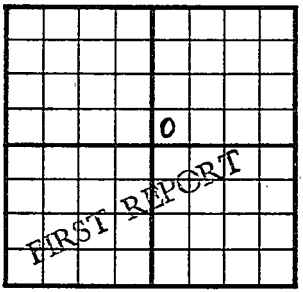

2345 Ft. From N Line NE

2433 Ft. From E Line Quarter

1st. Report JAN 3 1951

Completion

Remarks

Spudding Date 12-12-50

Drlg. Data Hugoton Pool

10" @ 580 TD 2705 7" @ 2443

Set 284' of 5" liner

J. E. TYRA

FORM 275 FOR SALE BY KANSAS BLUE PRINT CO.


County Grant State Kansas

Sec. 12 (Blk. Twp.) 30 (Sur. Rge.) 37W Map No.

Operator Hugoton Prod.

Well No. 1-12 Farm Hoehn

Elev. 3070 Location SW NE

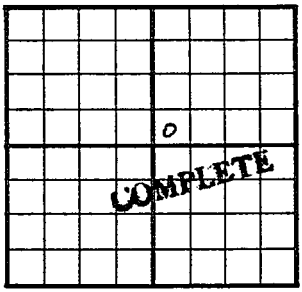

2345 Ft. From N Line NE

2433 Ft. From E Line Quarter

1st. Report

Completion FEB 7 1951

Remarks Hugoton Pool

Spudding Date 12-12-50

Drlg. Data Gas well TD 2705

10" @ 580 7" @ 2443 TD 2705

Hol. 2423 Her. 2464 Krider 2476

Win. 2546-85 Towanda 2615

16000 A Comp. 15,950,000 gas 408#

J. E. TYRA