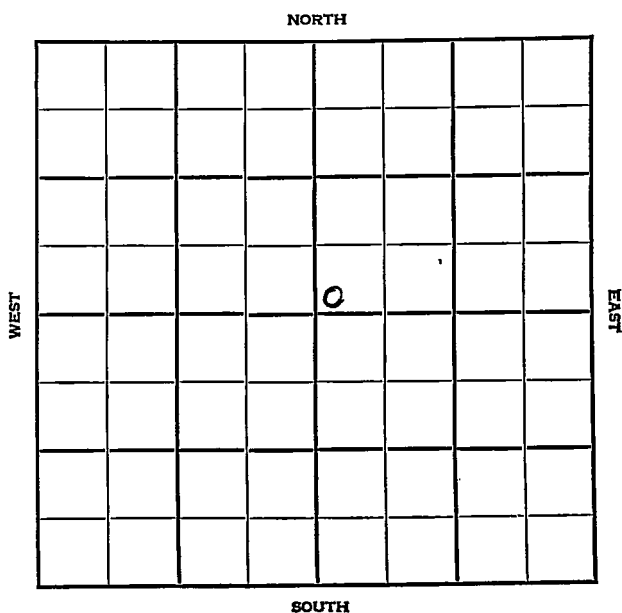


Section 12 Township 30 Range 40WWell No. #1 SprungerCompany Stanolind

KANSAS Stanton

Sec. 12 Twp. 30 R. 40W

Well No. #1 Springer Farm

Stanolind Company

Hugoton


 Ft. from N. Line

150 Ft. from S. Line

 Ft. from E. Line

150 Ft. from W. Line

SW NE

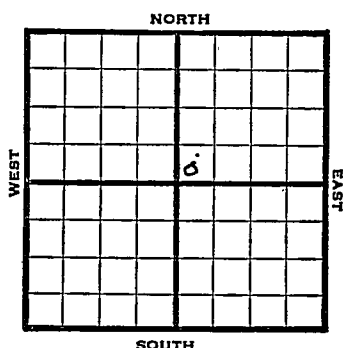

1947

Elev. 3246' REPORT

12/3

Location

12/10

8" @ 686 Drlg. 1925

12/30

5" @ 2498'
Perf.
15000 acid
2,700,000 gas.
425# R. Pr.
TD 2508'

COMPLETED

Map No. _____ Sec. 12 Twp. 30 R. 40WWell No. 1 Sprunger

_____ Stanolind _____ Company

FIRST REPORT

_____ Contractor

SW NE

SECTION PLAT

		o	

_____ Ft. from N. Line

150 Ft. from S. Line

_____ Ft. from E. Line

150 Ft. from W. Line

Stanton County

Location X

Rig up _____

Drilling and Remarks:

RECORD

Cased _____ in., _____ ft.

Sand _____

Gas _____

Oil _____

Total Depth _____

PRODUCTION

1st 24 hrs. Nat. _____

1st 24 hrs. after shot _____

Gas _____ Cu. Ft.

Dry Hole _____

Abandoned _____

Date

DEC 3 1947 19S. J. LEWIS Scout

Map No. _____ Sec. 12 Twp. 30 R. 40W

Well No. 1 Sprunger

Stanóind Company

COMPLETE

Contractor

SW NE


E13246
SECTION PLAT

_____ Ft. from N. Line

150 Ft. from S. Line

_____ Ft. from E. Line

150 Ft. from W. Line

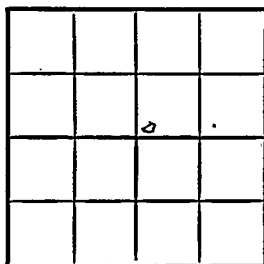

Stanton County

Location _____

Rig up _____

Drilling and Remarks:

5" C2498.

Perf.

100000000

2,700,000 gal

425* R/P

RECORD

Cased _____ in., _____ ft.

Sand _____

Gas _____

Oil _____

Total Depth 2505

PRODUCTION

1st 24 hrs. Nat. _____

1st 24 hrs. after shot _____

Gas _____ Cu. Ft.

Dry Hole _____

Abandoned _____

Date

DEC 30 1947

19

S. J. LEWIS

Scout