STATE OF KANSAS
STATE CORPORATION COMMISSION

Form CP-4

REC'D NOV 1 1972

WELL PLUGGING RECORD

Give All Information Completely
Make Required Affidavit
Mail or Deliver Report to:
Conservation Division
State Corporation Commission
P. O. Box 17027
Wichita, Kansas 67217

NORTH

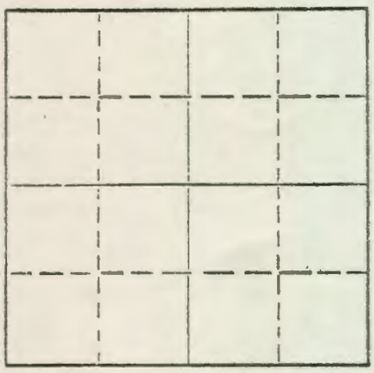

Locate well correctly on above Section Plat

Barber County. Sec. 17 Twp. 30S Rge. 13W(E) (W) X

Location as "NE/CNW¼SW¼" or footage from lines SW SE

Lease Owner Glen N. Rupe

Lease Name Lemon Well No. 1

Office Address 925 Olive Garvey Bldg., Wichita, Kansas

Character of Well (completed as Oil, Gas or Dry Hole) D&A

Date well completed September 25 19 72

Application for plugging filed September 25 19 72

Application for plugging approved September 25 19 72

Plugging commenced September 25 19 72

Plugging completed September 25 19 72

Reason for abandonment of well or producing formation D&A

If a producing well is abandoned, date of last production 19

Was permission obtained from the Conservation Division or its agents before plugging was commenced? Yes

Name of Conservation Agent who supervised plugging of this well G. R. Biberstein

Producing formation Depth to top Bottom Total Depth of Well 1123 Feet

Show depth and thickness of all water, oil and gas formations.

OIL, GAS OR WATER RECORDS — CASING RECORD

FORMATION	CONTENT	FROM	TO	SIZE	PUT IN	PULLED OUT
				8-5/8"	258'	-0-

Describe in detail the manner in which the well was plugged, indicating where the mud fluid was placed and the method or methods used in introducing it into the hole. If cement or other plugs were used, state the character of same and depth placed, from feet to feet for each plug set.

Plugged hole 1123' to 950'. Set plug @ 250',
cemented with 85 sx from 250 to bottom of cellar.

(If additional description is necessary, use BACK of this sheet)

Name of Plugging Contractor Red Tiger Drilling Company

Address 1720 Wichita Plaza, Wichita, Kansas 67202

STATE OF Kansas, COUNTY OF Sedgwick, ss.

Virginia K. Albert (employee of owner) or (owner or operator) of the above-described well, being first duly sworn on oath, says: That I have knowledge of the facts, statements, and matters herein contained and the log of the above-described well as filed and that the same are true and correct. So help me God.

(Signature) Virginia K. Albert

1720 Wichita Plaza, Wichita, Kansas
(Address)

SUBSCRIBED AND SWORN TO before me this 30th day of October, 19 72

Barbara L. Derland
Notary Public.

My commission expires July 25, 1976.

BARBARA L. DERLAND
STATE NOTARY PUBLIC
SEDGWICK CO. KANSAS

Original mailed to Corp Commission 11-1-72