

DX 78-1

Kingman

KANSAS

Section 13 Township 30 Range 8 WWell No. # 1 Tjaden "A"Company N C R A

NORTH

WEST

EAST

						0.	

SOUTH

Kingman KANSAS

SEC.	TWP.	R.
13	30	8W

WELL NO.

1 Tjaden "A"

FARM

COMPANY

N C R A

CONTRACTOR

Garvey

Spivey Pool

Ft. from N. Line

330


Ft. from S. Line

990

Ft. from E. Line

Ft. from W. Line

SW SE SE

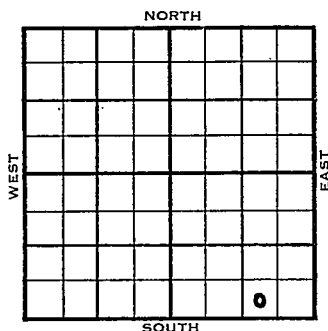

1954

ELEVATION

1546'

REPORT

10/13

Spud 10-5-54

8" @ 199'

Drlg. 3165'

11/23

Spud 10-5-54

Oil Well

TD 4350'

8" @ 199'

Lans 3396' Miss 4184'

DST 4192'-4239' opn 1 hr, 6,640,000 cfb
60' oil 1640#DST 4225'-39' opn 1 hr rec 365' free
oil, 60' mco, 1560#DST 4240'-61' opn 1 hr, rec 90' so &
gcm 440#DST 4262'-87' opn 1 hr, rec 200' Ho &
Gcm 1475#DST 4288'-4300' opn 1 hr, rec 25' Mud
12#

TD 4350'

5" @ 4348'

CO to 4313' 52/ 4272-85 S/ 23 go

5 gw 4 hr. 500 A F/ 136 bo 8 hr.


S/ 43 bo 2% Wtr. 1 hr.

Comp 239 bopd.

COMPLETED

FABEN GILSTRAP

County Kingman State Kansas
 Sec. 13 (Blk.) 30 (Sur.) 8W Map No.
 Operator N C R A
 Well No. 1 Farm Tjaden "A"
 Elev. 1546 Location SW SE SE

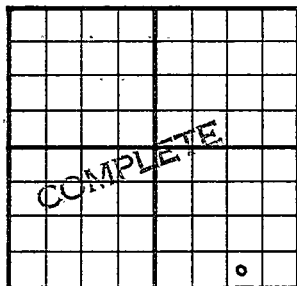

330 Ft. From S Line SE
990 Ft. From E Line Quarter

1st. Report

Completion NOV 23 1954

Remarks Spivey Pool
Garvey - Contr.

Spudding Date 10-5-54

Drlg. Data Oil well TD 4350

8" @ 199 Lans. 339.6 Miss. 4184

DST 4192-4239 open 1 hr. 6,640,000 cfg

60' oil 1640# DST 4225-39 open 1 hr.

Rec. 365' free oil 60' mco 1560#

DST 4240-61 open 1 hr. Rec. 90' so &

gcm 440# DST 4262-87 open 1 hr.

Rec. 200' ho & gcm 1475# DST. 4288-4300

open 1 hr. Rec. 25' mud 12# TD 4350

5" @ 4348 CO to 4313 52/ 4272-85

S/ 23 go 5 gw 4 hr. 500 A F/-136 bo

8 hr. S/ 43 bo 2% wtr. 1 hr.

Comp. 239 bopd

FABEN GIL