


Section 13 Township 30 Range 8W

Well No. #1 Joe Tjaden "G"

Company Stanoling Oil & Gas

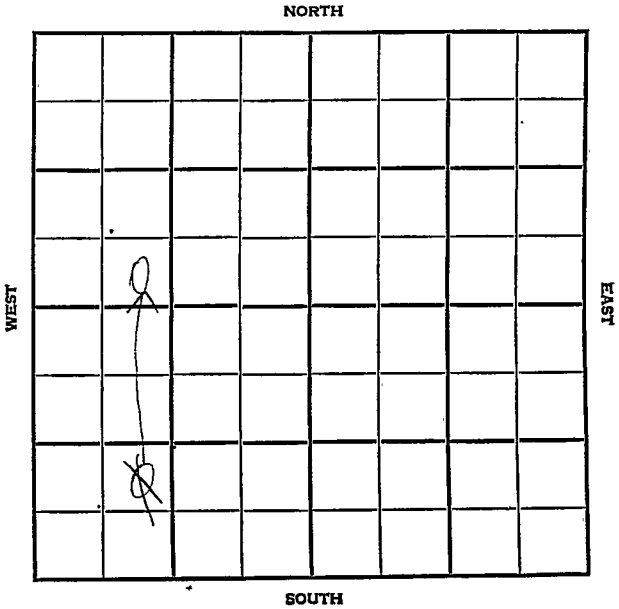

County Kingman Elev. _____
 Sec. 13 Twp. 30 Rge. 8W
 Company Stanö Lind Oil & Gas
 Farm Name Joe Tjaden "G" No. 1

TOPS	DEPTH	LOG	DATUM	Loc. in Sec.
Anb.				NE SW SW
Tp.				
H.				
Tr.				
Dg.				
BL.				
L.				Geol. _____
K.C.				Contr. _____
B.K.C.				Prime Drlg.
Ce.				Pool _____
C.				Spivey Grabs
M.				<div style="border: 1px solid black; padding: 5px;"> NOV 14 1956 FIRST REPORT </div>
M.				
K.				
Mz.				
Me.				
V.				
S.				
S.				
A.				
R.				
Pe.				
G.				
TD.				

Date Comm. _____
 Location _____

[Handwritten signature]

Co. No. Sec. T. R.

CORRECTION

FORM 513 SUNRAY

County	Kingman	Elev.	1478
Sec.	13 ⁿ	Twp.	30
		Rge.	8W
Company	Standlind Oil & Gas		
Farm Name	Joe Tjaden "G"		No. 1

TOPS	DEPTH	LOG	DATUM	Loc. in Sec.
Anh.				NE SW SW
Tp.				SE SW NW
H.				
Tr.				
Dg.				
Bl.				
L.				Geol.
K.C.				Contr.
B.K.C.				Prime Drlg.
Ce.				Pool
C.				Spivey Grabs
M.	4123			COMPLETE
M.	chert 4150			
K.				
Mz.				
Mo.				
V.				
S.				
S.				
A.				
R.				
PE.				
G.				
T.D.	4346			JAN 30 '57

Date Comm. NOV 21 '56 11-17-56 878 @
 194/250 WOC N 28 '56 17 3810 DEC 5
 DST 4123-50 1hr 6/2 1/2" ga
 290 MCF rec 225' GCM (550)
 BHP 320/20 DST 4151-95 1hr
 rec 100 SGCM + 120' GC & OCM
 BHP 970/30 5 1/2 4345/250
 DEC '25A CO 4309 32/4123-31 1/2
 frac 5' Fluid 1 3/4 Bot + 3 1/2 Bwph

Plus ga 250 MCF F1ae

\$ Cd. DEC 19 56 \$ 1 1/2 B Fph 7590

Wtr 12 hrs/da \$ 3 B0

+ 12 Bwph est ga 333 MCF

DEC 17 56 JAN 2 57 MICT 56 4123-31

REF 16/4123-27 Δ Flw

3 B0 + 7 Bwph 12 hrs

+ 5 + 9. JAN 3 57 \$ 2 1/2 B0 + 6 1/2

Bwph 12 hrs wost + 5T

JAN 1 - " JAN 23 57 JAN 3 Ph P.

24 B0pd + 96 Bwpd

+ gas ga 168 MCF G-PD

GOR 7000:1