DX 78-1

Kingman KANSAS

Section 13 Township 30 Range 8 W

Well No. # 3 Tjaden

Company N C R A

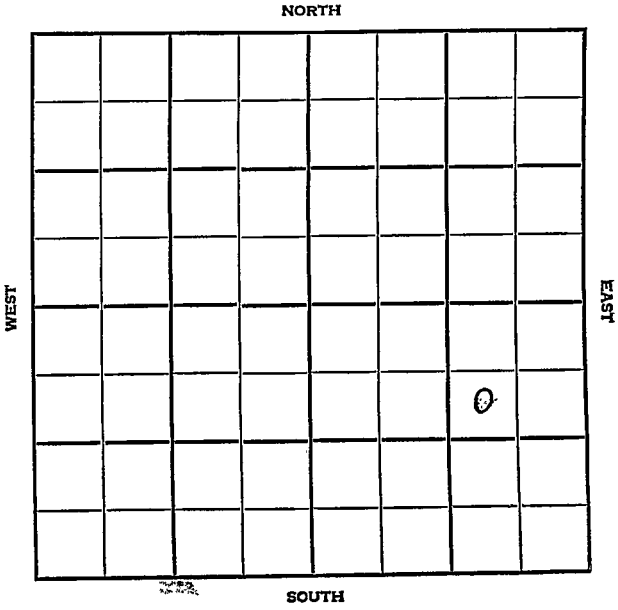

Kingman KANSAS

SEC.	TWP.	R.
13	30	8W

WELL NO.
#3 Tjaden FARM

COMPANY
N C R A

CONTRACTOR
Prime Drlg.

spivey Pool

990 Ft. from N. Line

Ft. from S. Line

990 Ft. from E. Line

Ft. from W. Line

SW NE SE

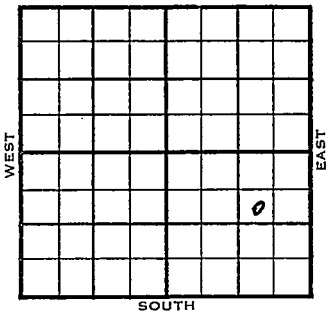

1955	ELEVATION 1497' REPORT
1/5	M I R
3/23	Spud 1-4-55, Oil Well, TD 4315 8" @ 206, Lans 3355, Miss 4140, DST 4150-70 open 1 hr gas in 34 min. Rec 40' mud 1425# DST 4170-90 gas in 27 min. open 1 hr. Rec 225' 1275# DST 4190-4210, open 1 hr Rec 45' mud 0#, DST 4209-30 open 1 hr. Rec 45' mud 0# DST 4229-50 open 1 hr. Rec 35' SOCM, 0# DST 4250-95 open 1 hr, Rec 30' mud 885#, TD 4315, 5" @ 4313- CO to 4279, 56/4168-82, B/59 go 3 hr. 500 A S/34 BO 7 hr. A-fr$_a$c S/8 BFPH 45% wtr. 5 hr. Comp. 127 BOPD 6% wtr.

COMPLETED

DX-78

FORM 275 FOR SALE BY KANSAS BLUE PRINT CO.

County Kingman State Kansas

Sec. 13 (Blk. Twp.) 30 (Sur. Rge.) 8W Map No.

Operator N C R A

Well No. 3 Farm Tjaden

Elev. Location SW NE SE

990 Ft. From N Line SE

990 Ft. From E Line Quarter

1st. Report JAN 5 1955

Completion

Remarks

Prime Drlg. - Contr.

Spudding Date

Drlg. Data Spivey Pool

M I R

FIRST REPORT

FABEN GILSTRAP

FORM 275 FOR SALE BY KANSAS BLUE PRINT CO.

County Kingman State Kansas

Sec. 13 (Blk. Twp.) 30 (Sur. Rge.) 8W Map No.

Operator N C R A

Well No. 3 Farm Tjaden

Elev. 1497 Location SW NE SE

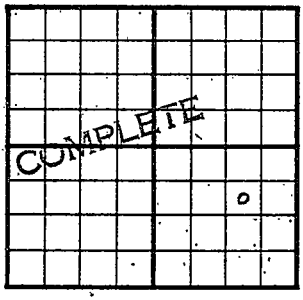

990 Ft. From N Line SE

990 Ft. From E Line Quarter

1st. Report

Completion MAR 23 1955

Remarks Spivey Pool

Prime Drlg. - Contr.

Spudding Date 1-4-55

Drlg. Data Oil well TD 4315

8" @ 206 Lans. 3355 Miss. 4140

DST 4150-70 open 1 hr. gas in 34 min.

Rec. 40' mud 1425# DST 4170-90

gas in 27 min. open 1 hr. Rec. 225'

mw 1275# DST 4190-4210 open 1 hr.

Rec. 45' mud 0# DST 4209-30 open 1 hr.

Rec. 45' mud 0# DST 4229-50 open 1 hr.

Rec. 35' socm 0# DST 4250-95 open 1 hr

Rec. 30' mud 885# TD 4315 5" @ 4313

CO to 4279 56/ 4168-82 B/ 59 go

3 hr. 500 A S/ 34 bo 7 hr. A-frac

S/ 8 bfph 45% wtr. 5 hr.

Comp. 127 bopd 6% wtr.

FABEN GILSTRAP