


Kingman

KANSAS

SECTION 13 TOWNSHIP 30 RANGE 8W

WELL NO. #1 Tjaden #5 "A"

COMPANY N C R A

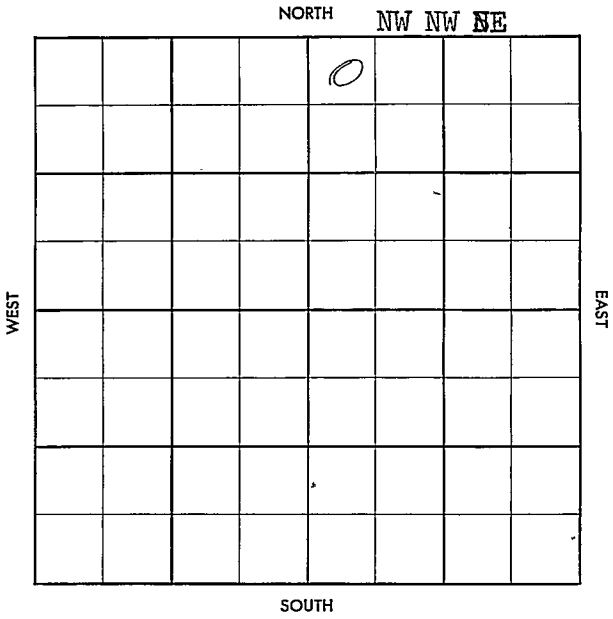

County Kingman Elev. _____
 Sec. 13 Twp. 30 Rge. 8W
 Company N. C. R. A.
 Farm Name Tjaden "B" No. 1

TOPS	DEPTH	LOG	DATUM
Anh.			
Tp.			
H.			
Tr.			
Dg.			
Bl.			
L.			
K.C.			
B.K.C.			
Ce.			
C.			
M.			
M.			
K.			
Mz.			
Mo.			
V.			
S.			
S.			
A.			
R.			
PE.			
G.			
T.D.			

Loc. in Sec. NW NW NE

Geol. _____
 Contr. _____

Sierra Drlg.

Pool _____
Spivey-Grabs

FIRST REPORT			
APR 3 '57			

Date Comm. _____
 Location _____

Co.
 Sec.
 T.
 R.

[Handwritten signature]

CORRECTION

FORM 519 SUNRAY

Co.

L.S.

No.

Sec.

T.

R.

County Kingman Elev. 1473
 Sec. 13 Twp. 30 Rge. 8W
 Company N. C. R. A.
 Farm Name Tjaden ~~117~~ "A" No. 75

TOPS	DEPTH	LOG	DATUM	Loc. in Sec.
Anb.	909			NW NW NE
Tr.				
H.				
Tr.				
Dg.				
Bl.				
L.	3340			Geol.
K.C.				Contr.
B.K.C.				
Ce.				Sierra D. L.
C.				
M.	4104			Pool
M.				Spivey-Grabs
K.				
Mz.				
Me.				
V.				
S.				
S.				
A.				
R.				
PE.				
G.				
T.B.	4202			2157 COMPLETE

Date Comm. _____
 Location APR 10 '57 ~~X~~ LOC. APR 17 '57 4-8
-57 85' 8 257/155 @ 3703
APR 24 '57 DST 4103-19 1hr G 1 3/2" ga
517 MCF/15" 486 MCF/30" 458 MCF
1hr rec 65' VSGCM BHP 1405/20
DST 4119-34 1hr G 1/2" ga 439
MCF/5" 295 MCF/30 280 MCF/1hr
rec 30' SOC 955y Md +60' SOC WM
+70' oily wth (30 to oil) FP 165

-144 BHP 1375/20 DST
 4138-54 1hr G-42" no ga
 rec 90' 50CM + 10' WM FP
 0-60 BHP 1035/20 DST
 4155-69 1hr 1386' G-1R
 rec 90' 50' E' 6' CW.M FP 0
 BHP 630/20" DST 4169-82
 1hr 120' G-1R rec 50' 50CM
 W FP 0 BHP 180/20"
 5 1/2 (4200) 75 MAY 1 '57 CO 4169
 32/4136-44 FU 75' Fluid
 (50% wt + SG) 28/4117-24:
 To Acid MAY 8 '57 1 1/2 Fluid 2
 BF 70% oil 1hr FRAC
 Fluid 41.68 BF 30% wt
 in 3 hrs Fluid 128 BF
 50% wt 12 hrs 16/64" ch
 MAY 15 '57 MAY 22 '57 MAY 29 '57 JUN 5 '57 JUN 12 '57 JUN 19 '57
 JUN 26 '57 JUL 3 '57 JUL 10 '57 X W8 Pot JUL 17 '57
 JUL 24 '57 JUL 31 '57 AUG 7 '57 AUG 14 '57 AUG 21 '57

F/Q 27B0 + 38% X G 837,000CF

M-50 447-94