

KANSAS

Well No. #1 Leonard

Company Panhandle Eastern

WEST

EAST

SOUTH

KANSAS
Haskell

Sec. 13 Twp. 30 R. 33W

Well No. #1 Leonard Farm

Panhandle Eastern Company

Moran Contractor

Hugoton Pool


 Ft. from N. Line

2540' Ft. from S. Line

2743' Ft. from E. Line

 Ft. from W. Line

NE SW

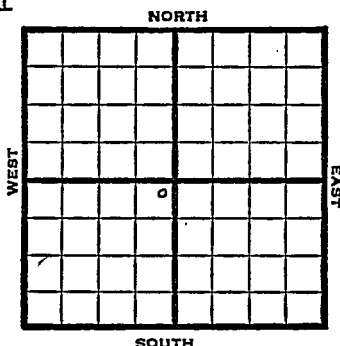

1950

Elev 2927

REPORT

6/21

Spud 6-16-50
10" @ 477'
WOC

8/2

10" @ 477
7" @ 2601
TD 2740
Her 2603 Krider 2630
Win 2703
15,000 total acid
Comp 8,188,000 open flow 412#
Completed

COMPLETED

Map No. _____ Sec. 13 Twp. 30 R. 33WWell No. 1 Leonard

_____ Panhandle Eastern _____ Company

_____ Moran _____ Contractor

NE SW

SECTION PLAT

_____ Ft. from N. Line

2540 Ft. from S. Line2743 Ft. from E. Line

_____ Ft. from W. Line



Haskell County

Location _____

Rig up _____

Drilling and Remarks:

Spud 6-16-50

10" @ 477

WOC

RECORD

Cased _____ in., _____ ft.

Sand _____

Gas _____

Oil _____

Total Depth _____

PRODUCTION

1st 24 hrs. Nat. _____

1st 24 hrs. after shot _____


Gas _____ Cu. Ft.

Dry Hole _____

Abandoned _____

Date

JUN 21 1950 19 J. E. TYRA Scout

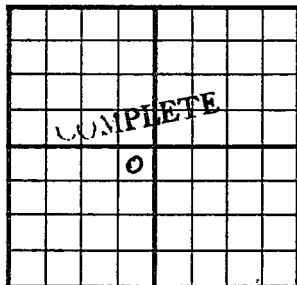County Haskell State KansasSec. 13 (Blk.
Twp.) 30 (Sur.
Rge.) 33W Map No.Operator Panhandle EasternWell No. 1 Farm LeonardElev. 2927 Location NE SW2540 Ft. From S Line Sec.2743 Ft. From E Line QuarterIst. ReportCompletion AUG 2 1950RemarksSpudding Date 6-16-50Drlg. Data Hugoton Pool10" @ .477 7" @ .2601 TD 2740Her. 2603 Krider 2630 Win. 270315,000 total acidComp. 8,188,000 open flow 412#

J. E. TYRA