

KANSAS

Section 13 Township 30.S Range 34W

Well No. 1 City

Company City of Stanta

Hugoton

NORTH

			0				

WEST

EAST

SOUTH

KANSAS

Haskell

Sec. 13 Twp. 30 R. 34W

Well No. #1 City Farm _____

City of Satanta

Company _____

Hugoton Pool


1700' Ft. from N. Line

_____ Ft. from S. Line

_____ Ft. from E. Line

2540' Ft. from W. Line

NE SE NW

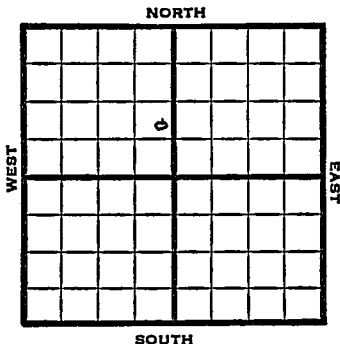

1949

Elev 2969' REPORT

- 4/6 Location
- 4/12 "
- 4/20 10" @ 640'
- 4/27 TD 2596'
7" @ 2587'
- 5/4 "
- 5/10 "
- 5/18 "
- 5/25 "
- 6/1 TD 2750'
20,000 acid
- 6/8 7" @ 2587'
TD 2750'
20000 acid
17,161,000 Gas
419# R Pr.
Comp

COMPLETED

Map No. _____ Sec. 13 Twp. 30 R. 34W

Well No. 1 City _____

_____ City of Satanta _____ Company

_____ **FIRST REPORT** _____ Contractor

NE SE NW

SECTION FLAT

1700 Ft. from N. Line

_____ Ft. from S. Line

_____ Ft. from E. Line

2540 Ft. from W. Line

		□	

Haskell County

Location X

Rig up _____

Drilling and Remarks: _____

RECORD

Cased _____ in., _____ ft.

Sand _____

Gas _____

Oil _____

Total Depth _____

PRODUCTION

1st 24 hrs. Nat. _____

1st 24 hrs. after shot _____

Gas _____ Cu. Ft.

Dry Hole _____

Abandoned _____

Date

APR 6 1949 19 _____

S. J. LEWIS Scout

Haskell County Kansas State

Map No. ✓ Sec. 13 Twp. 30 R. 34W

Well No. 1 City

City of Satanta Company

COMPLETE

Contractor

NE SE NW

E 1,2969

SECTION PLAT

1700 Ft. from N. Line

 Ft. from S. Line

 Ft. from E. Line

2540 Ft. from W. Line

Hugoton Pool

Remarks:

2" @ 2582
74250.
20000 Grad
17,161,000 Gas
419 # R/3

Date **JUN 8 1949**

Scout **S. J. LEWIS**