

KANSAS


Kiowa

FORM 51 5M BRIX

Section 14 Township 30 Range 10W

Well No. #1, Alford

Company Lion Oil Ref.

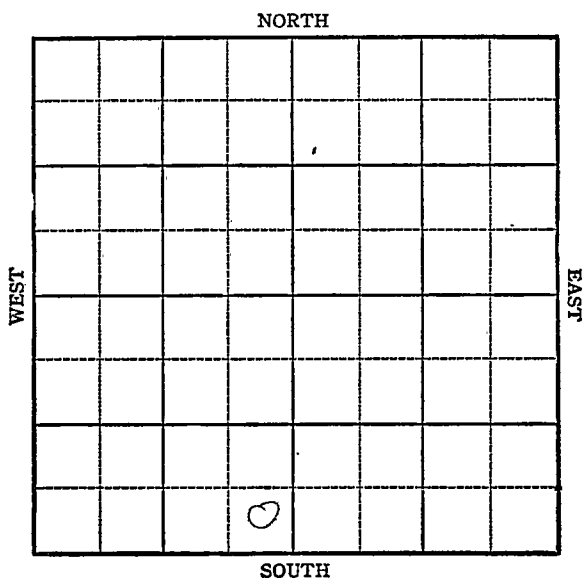


Sec. 14 Twp. 30 R. 19W

Well No. #1 Alford Farm

Lion Oil Ref. Company

Wildcat

NORTH

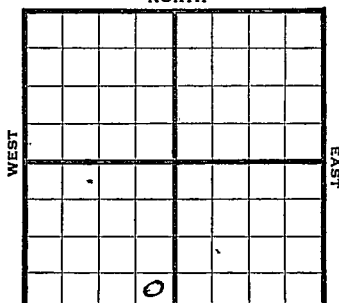

 Ft. from N. Line

330 Ft. from S. Line

330 Ft. from E. Line

 Ft. from W. Line

Elev. 2234

SOUTH

1944

REPORT

5/24	Location
5/31	"
6/7	"
6/15	"
6/21	800 Run csg.
6/28	10" @ 859 Drlg 2650
7/12	Drlg 4444
7/19	Lans 4402 Drlg 4740
7/26	Miss 5040 Drlg. 5105
8/2	Drlg. 5380
8/9	Viola 5483? Drlg. 5665
8/16	Drlg. 5730
8/23	Viola 5688 corrected Simp. Sd 5766 Arb 5787 TD 5850 Run 5" to 5100
8/30	5" @ 5113 to perforate
9/8	12 shots 5035-39 no shows 12 " 5039-43 500 aci <i>over</i>

Estim. 4 MG

1944

9/13 Miss 5040'
5" @ 5113'
Arb 5787'
48 shots 5035-5053
6000 acid.
TD 5850'
3,200,000 Gas
1100# Rock Pressure

COMPLETED


Pool Name WildcatMap No. 9 D Sec. 14 Twp. 30 R. 19 WWell No. 1 Alford

Lion Oil Ref. _____ Company

FIRST REPORT _____ Contractor

SE SW

SECTION PLAT

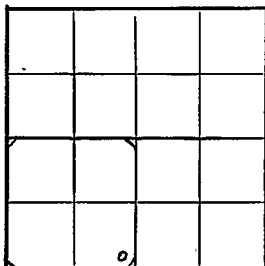

_____ Ft. from N. Line

330

_____ Ft. from S. Line

330

_____ Ft. from E. Line

_____ Ft. from W. Line

Kiowa County

Location X

Rig up _____

Drilling and Remarks:

RECORD

Cased _____ in., _____ ft.

Sand _____

Gas _____

Oil _____

Total Depth _____

PRODUCTION

1st 24 hrs. Nat. _____

1st 24 hrs. after shot _____


Gas _____ Cu. Ft.

Dry Hole _____

Abandoned _____

Date

MAY 24 1944 19S. J. LEWIS Scout

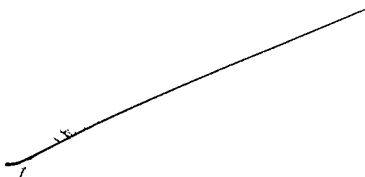

Misc. Small Maps	<i>Orma</i>
Cards	<i>Beulah</i>
Tracing	<i>M. V. L.</i>
France Map	<i>1</i>
Carborough Map	<i>1</i>
Force Map	<i>1</i>
ological Dept.	
Plat Book	

Pool Name WildcatMap No. 90 Sec. 14 Twp. 30 R. 19WWell No. 1 Alford

Lion Oil Ref.

Company

COMPLETED

Contractor

SE SW

COMPLETED

Ft. from N. Line

330 Ft. from S. Line330 Ft. from E. Line

Ft. from W. Line

SECTION PLAT

Kiowa County

RECORD

Location

Rig up

Drilling and Remarks:

*Alford 5040**5" 05113**Car 45787**45 hrs to 5000-53**6000 acid**3,200,000 Gas.*Cased in ft.

Sand

Gas

Oil

Total Depth 5730

PRODUCTION

1st 24 hrs. Nat.

1st 24 hrs. after shot

Gas Cu. Ft.

Dry Hole

Abandoned

1100 # Rock 92

Date

SEr

SEP 13 1944 19

S. J. LEWIS

Scout

Misc. Small Maps

Cards

Tracing

France Map

Scarborough Map

Moody Map

Geological Dept.

Moody Plat Book

Reid

Reid