

O.W.W.O.

KANSAS.


DX 78-1 Kiowa

Section 14 Township 30 Range 19W

Well No. #1 Miller

Company ~~Anschutz Drilling~~ Graham-Michaelis & *Price*

NORTH

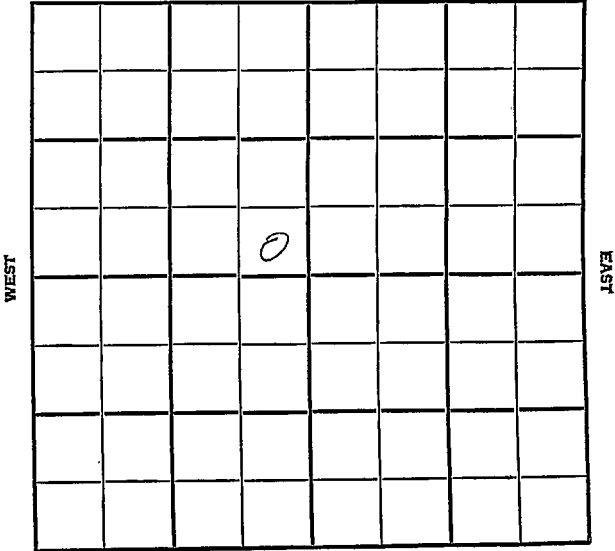

SOUTH

Kiowa

KANSAS

SEC. 14	TWP. 30	R. 19W
------------	------------	-----------

WELL NO.

#1 Miller FARM

COMPANY

Anschutz Drlg.

CONTRACTOR

G-M

WILDCAT


_____ FT. FROM N. LINE

_____ FT. FROM S. LINE

_____ FT. FROM E. LINE

_____ FT. FROM W. LINE

SE SE NW

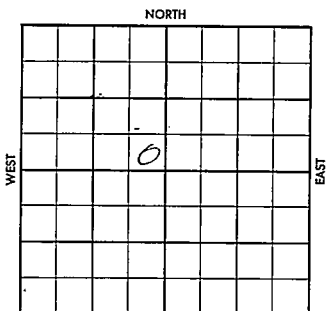

Pure - D^{SH}
Rep. Nat. - F0

1956	ELEVATION	REPORT
------	-----------	--------

8-15 Location


RS
O.W.W.O.

S-513-B

County Kiowa Elev. _____
 Sec. 14 Twp. 30 Rge. 19W
 Company Graham-Michaelis & Pure
 Farm Name C. A. Miller No. 1

TOPS	DEPTH	LOG	DATUM
Anh.			
Tp.			
H.			
Tr.			
Dg.			
B.L.			
L.			
K.C.		1385	
B.K.C.		1953	
Ce.			
C.		1841	
M. <u>erm</u>		5020	
M. <u>iss</u>			
K.			
Mz.			
Mq.			
V.			
S.			
S.			
A.			
R.			
Pf.			
G.			
T.D.			

Loc. in Sec. _____
 SE SE NW
 O.W.W.O.
 Geol. O.W.W.O.
 Contr. _____
 Pool Alford

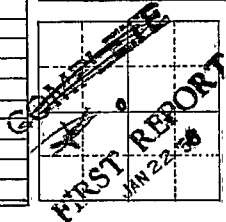

Date Comm. OTD 5126 5" @ 5123 PB 5065
36/ 5046-52 4,000 mcfg 500 MA
6,130 mcfg DUAL COMP. Oil and Gas

Co.

USE.

Location

3291



No.

505



Co.


Elev.

Sec. 14 Twp. 30

Rge.

19WCompany Anschutz Drlg.FarmName Miller

No.

1

TOPS	DEPTH	LOG	DATUM	Loc. in Sec.
Anb.				SE SE NW
TP.				
H.		4192		
Tr.				
Dg.				
BL.	4385	4385		
L.	4407	4402		
K.C.				Geol.
B.K.C.		4818		
Ce. <u>Martin</u>		4878		Contr.
C.				G-M
M.	5027	5020		
M.		"		Pool <u>Alford</u>
K.				<u>Wildcat</u>
Mz.				
Me.				
V.				
S.				
S.				
A.				
R.				
PE.				
G.				
TD.	5125			COMPLETE

Lse.

No.

Sec.

T.

R.

Date Comm. Pure - DHM Rep. Nat. - FOLocation AUG 22 '56 8-15-56 85/8530 / 500 ID 870 AUG 29 '56ID 3963 SEP 5 '56 DST 5030 - 42G/3" ga 3.780 MCF / 17"stabil @ 3.400 MCF in 47"or 1 hr rec. 30' Md FP1070-945 1510/45" ID SEP 12 '56 DST5042-55 1 hr G/2" ga 3.310 MCFin 5" 4.830/15" rec 30' Md

FP 1350-1065 BHP 1455
 DST 5055-80 1hr. rec 205'
 SGCM +150' GCE 50C +30'
 OEGCM BHP 500 120" DST
 5075-89 of 75" rec 80'
 SOEGCM +180' HOEGCM +Tr.
 wtr BHP 550 120" 5 1/2 @
 5123 SEP 19 '56 CO 5105 16/5078
 -82 \$ 35.07 GO 2 hrs
 1/2 \$ 3.34 Boph 10 hrs
 A \$ 1.67 Boph 6 hrs
 to SO SEP 26 '56 16/5074-78
 1/2 \$ 13.36 Bo no/w
 1hr \$ 2.05 Bo no/w
 Last hr of 6 hr test 1/2
 \$ 3.34 Boph no/w
 8 hrs OCT 3 '56 POP OCT 10 '56 P.
 98 Bo 16 hrs decl. to
 49.17 Bo in 24 hrs OCT 17 '56
 P. 37 1/4 Bo + 3% wtr 24
 hrs. OCT 24 '56 OCT 31 '56 ~~X-1000~~
~~completes~~ NOV 7 '56 P.
 40 Bopd + 2% wtr
 grav. 34°

O.W.W.O. Twp. Pool

Co. Facet

S-513-B

County Kiowa Elev. _____
 Sec. 14 Twp. 30 Rge. 19W
 Company Graham-Michaelis & Pure Oil
 Farm Name C. A. Miller No. 1

TOPS	DEPTH	LOG	DATUM
Anh.			
Tp.			
H.			
Tr.			
Dg.			
B.L.			
L.			
K.C.			
B.K.C.			
Ce.			
C.			
M.			
M.			
K.			
Mz.			
Mq.			
V.			
S.			
S.			
A.			
R.			
Pf.			
G.			
T.D.			

Loc. in Sec. _____

SE SE NW

(O.W.W.O.)

Geol. U. W. 1911

Contr. _____

Pool _____

Alford

APR 30 58		
COMPLETE		

Date Comm. OLD INFO: Log Tops: LKC 4385, Marm.
4841, Cheo 4953, Miss 5020, OTD 5126, 5" @
5123 w/150 was Miss oil Producer from perfs
5074-78 (was Anshutz Drlg.)
NEW INFO: will dually comp. as oil and gas
well - PB 5065, 36/5046-52 G 4,000,000 cfg/
D, MA/500 G 6,130,000 cfg/D tstg. JAN 28 58
Flo 14 BOPH no wtr 3 hrs. 3000 Acid, Flo
1.75 BOPH no wtr no time, 4000 Acid Swab 2
BOPH no wtr no time testing. FEB 12 58 \$10-
11 BOPH NW 5 hrs \$5 BOPH NW 2 hrs

Fl 0 1.67 B0 ph + ga 600 mcf
 12 hrs FEB 12 58 Tbg w PKR
 5041 5029-35 with (5)
 \$ 5B FPH 9090 w 7 hrs \$ 1 1/2 B
 Fph 600/w 2 1/2 hrs + stg
 FEB 19 58 FEB 20 58 (5) Ga 300 mcf +
 3 B wph \$ 1 B wph + ga
 162 mcf CO 5096 PKR 4979
 1 1/2 channeled \$ 1 1/2 B FPH 5090
 oi' ga 162 mcf PB 5065
 PKR 5040 (3) POP to re
 Ld MAR 5 58 MAR 19 58 P 35 B0
 + 12 B0 24 hrs P 20 B0 + 16 BW
 ga 100 mcf 24 hrs MAR 26 58
 APR 2 58 APR 9 58 APR 23 58 APR 30 58
 P/ 16 hr 13 hr 75 mcf

Miss