


Section 14 Township 30 Range 13W

Well No. #1 Hittle

Company Rupp-Ferguson Oil

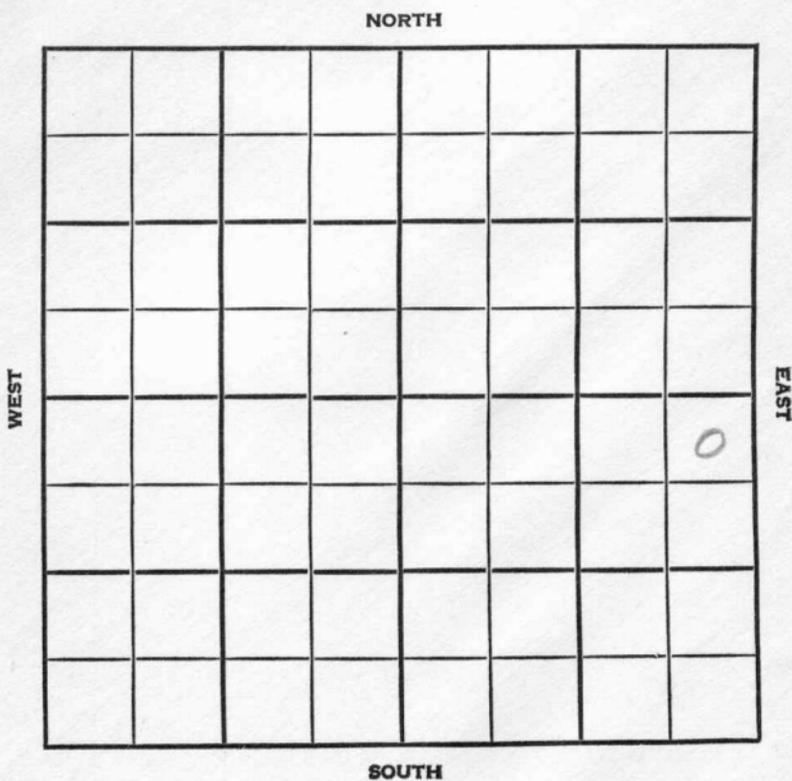

Barber

KANSAS

SEC. 14	TWP. 30	R. 13W
------------	------------	-----------

WELL NO. **1 Hittle** FARM

COMPANY  
**Rupp-Ferguson Oil**

CONTRACTOR


**Wildcat**

**330'** Ft. from N. Line

\_\_\_\_\_ Ft. from S. Line

**330'** Ft. from E. Line

\_\_\_\_\_ Ft. from W. Line

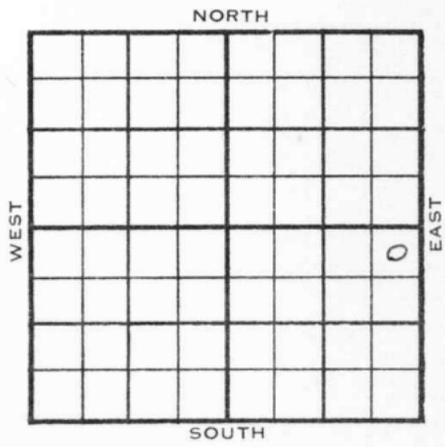

NE NE SE  
Arb Test  
Atl & Gulf Support

	ELEVATION	REPORT
1955		
5/25		<b>Location</b>
6/15		Comm 5-27-55 8 5/8", @341/275, DST 3730-60, open 1 hr. Rec. 20' mud O# DST4206-21, open 1 hr. Rec. 30' mud 60/20" D&A.
	Tops:	Depth Log Datum
	H.	3669 1877
	Dg.	3731 1939
	BL.	3815 2036
	L.	3830 2051
	M.	4284 2492
	K.	4379 2587
	V.	4459 2663
	S. Sh.	4575 2783
	S. Sd.	4595 2798
	A.	4675 2881
	TD.	4705

**ABANDONED**

County Barber State Kansas

Sec. 14 (Blk. Twp.) 30 (Sur. Rge.) 13W Map No.

Operator Rupp-Ferguson Oil

Well No. 1 Farm Hittle

Elev. \_\_\_\_\_ Location NE NE SE


330Ft. From N Line SE

330Ft. From E Line Quarter

1st. Report MAY 25 1955

Completion \_\_\_\_\_

Remarks Arb. test

Spudding Date \_\_\_\_\_

Drig. Data Sinc. Atl. & Gulf support Wildcat  
 Location \_\_\_\_\_

*C-26*

County Barber ✓ Elev. 1792  
 Sec. 14 Twp. 30 Rge. 13W  
 Company Rupp-Ferguson Oil  
 Farm Name Hittle No. 1

TOPS	DEPTH	LOG	DATUM
Anh.			
Tp.			
H.		3669	1877
Tr.			
Dg.	3731		1939
Bl.	3815	3828	2031
L.	3830	3843	2051
K.C.			
B.K.C.			
Ce.			
C.			
M.	4284	4284	2492
M.			
K.	4379		2587
Mz.			
Mq.			
V.	4459	4455	2663
S.	4584	4575	2783
S.	4595	4590	2798
A.	4675	4673	2881
R.			
PC.			
G.			
T.D.	4705		

Loc. in Sec. NE NE SE

Geol. \_\_\_\_\_  
 Contr. \_\_\_\_\_

Pool Wildcat



Date Comm. 5-27-55 JUN 15 1955  
8 5/8" @ 341/275 DST 3730-60 open 1 hr  
Rec. 20' mud 0# DST 4206-21 open  
1 hr. Rec. 30' mud 60/20"  
D & A

Co.  
 Lse.  
 No.  
 Ser.  
 T.  
 R.