
KANSAS Grant County

FORM 51 5M PETROL

Section 14 Township 30 Range 36W

Well No. 1 Teeter

Company United Prod.

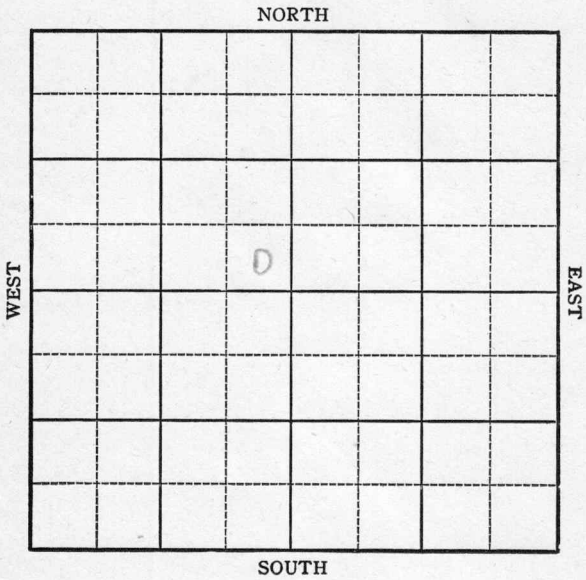

FORM 252-A
5M 3-45 PETROL

KANSAS


Grant

Sec. 14 Twp. 30 R. 36W

Well No. 1 Teeter Farm

United Prod. Company

Hugoton

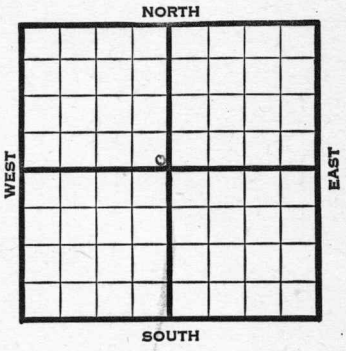

____ Ft. from N. Line

100 Ft. from S. Line

100 Ft. from E. Line

____ Ft. from W. Line

SE NW Elev. 3004

1945	REPORT
5/9	10" -560 1810
5/17	7" @ 2520 Drlg. 2640
5/24	TD 2730 225' of 5" perf. liner @ 2730 WOC
5/31	" " " " " " "
6/8	" " " " " " "
6/14	" " " " " " "
6/21	" " " " " " "
6/28	" " " " " " "
7/3	" " " " " " "
7/11	" " " " " " "
7/19	" " " " " " "
7/26	" " " " " " "
8/1	TD 2730' 2215' of 5" perf. liner @ 2730 WOC
8/8	8000 acid
8/15	" "
8/22	" "
8/29	" "
9/5	" "
9/12	" "
9/19	" "
9/26	7" @ 2520 225' of 5" Perf. liner @ 2730 . 8000 acid. TD 2730' 6,594,000 Gas. 405# RPr.

COMPLETED

FORM 26 200 BKS. 2-44 PETROL

-Kansas Pool Name Hugoton

Map No. no map Sec. 14 Twp. 30 R. 36W


Well No. 1 Teeter

United Prod. Company

FIRST REPORT Contractor

SE NW

SECTION PLAT

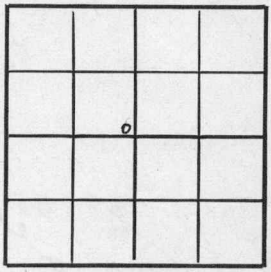

____ Ft. from N. Line

100 Ft. from S. Line

100 Ft. from E. Line

____ Ft. from W. Line

Grant

Location

Rig up

Drilling and Remarks:

10"-560 1810

RECORD

Cased ____ in., ____ ft.

Sand

Gas

Oil

Total Depth.

PRODUCTION

1st 24 hrs. Nat.

1st 24 hrs. after shot

Gas ____ Cu. Ft.

Dry Hole

Abandoned

Date

MAY 9 1945

19 ____

S. J. LEWIS Scout

FORM 26 200 BKS 1-44 PETROL

KANSAS Kansas

Pool Name Hugoton

Map No. ~~no map~~ Sec. 14 Twp. 30 R. 36W

Well No. 1 Teeter


United Prod. Company

COMPLETED Contractor

SE NW

L7, 3504

SECTION PLAT

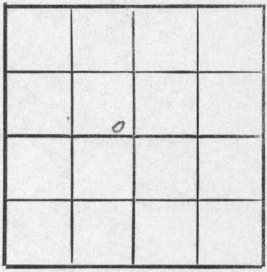

Ft. from N. Line

100 Ft. from S. Line

100 Ft. from E. Line

Ft. from W. Line

Grant County

Location

Rig up

Drilling and Remarks:

7" @ 2520

225 sx 5" Pet. Liner

@ 2730

8000 acid

6,594,000 Gas

405# RP

RECORD

Cased in., ft.

Sand

Gas

Oil

Total Depth 2730

PRODUCTION

1st 24 hrs. Nat.

1st 24 hrs. after shot

Gas Cu. Ft.

Dry Hole

Abandoned

Date

SEP 2 6 1945 19

S. J. LEWIS Scout