


Section 14 Township 30 Range 33W
Well No. #1 Pechin
Company Panhandle Eastern

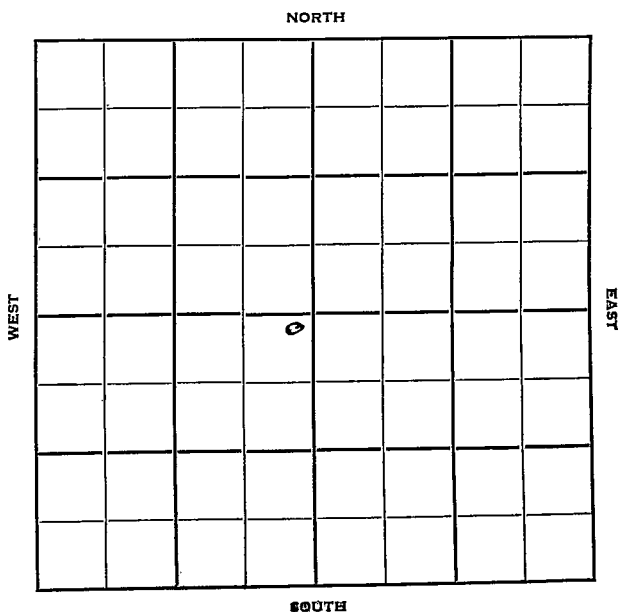

Haskell
30

KANSAS

Sec. 14 Twp. 33W R. ✓

Well No. #1 Pechin Farm

Panhandle Eastern Company

Hugoton Pool Contractor


100' Ft. from N. Line

 Ft. from S. Line

100' Ft. from E. Line

 Ft. from W. Line

NE SW

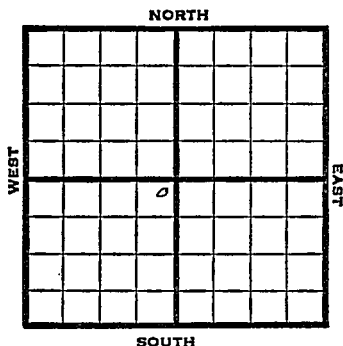

1950

Elev 2934

REPORT

3/15

Location

8/2

7" @ 2590

TD 2730

Krider 2522

Win 2696

3000 A

Comp 3,346,000 gas

Completed

COMPLETED

Map No. _____ Sec. 14 Twp. 30 R. 3 3WWell No. 1 PechinPanhandle Eastern

Company

Contractor

NE SW

SECTION PLAT

100 Ft. from N. Line Ft. from S. Line100 Ft. from E. Line Ft. from W. LineHaskell CountyLocation X

Rig up _____

Drilling and Remarks:

RECORD

Cased _____ in., _____ ft.

Sand _____

Gas _____

Oil _____

Total Depth _____

PRODUCTION

1st 24 hrs. Nat. _____

1st 24 hrs. after shot _____

Gas _____ Cu. Ft.

Dry Hole _____

Abandoned _____

Date

MAR 15 1950 19J. E. TYRA Scout

