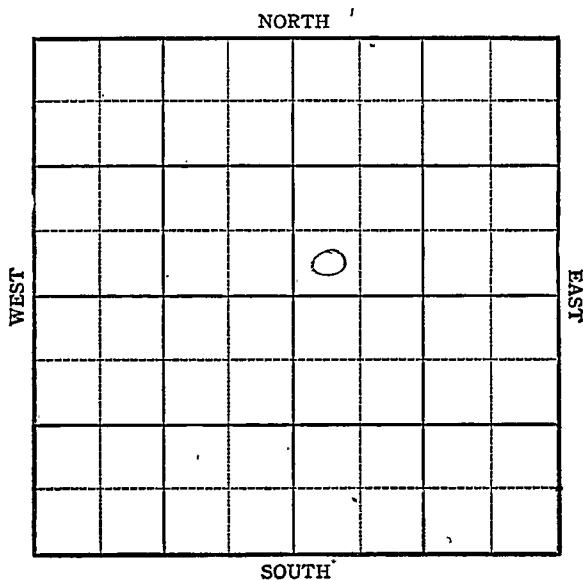


KANSAS

Haskell County

Section 14 Township 30 Range 34WWell No. #4 HuxmanCompany United Prod.


KANSAS

Haskell County

Sec. 14 Twp. 30 R. 34W

Well No. #4 Huxman Farm

United Prod. Company
Hugoton

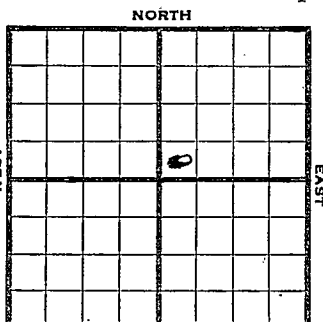

 Ft. from N. Line

100 Ft. from S. Line

 Ft. from E. Line

100 Ft. from W. Line

SW NE Elw. 2971

1944

R E P O R T

10/18 Location

10/25 "

11/1 "

11/8 "

11/16 "

11/24 "

11/29 Derrick

12/6 10" @ 6188 Drlg. 1200'

12/14 Drlg. 2230'

12/21 7" @ 2515'

TD 2715

229' of 5" Perf. Liner @ 2715.

12/29 7" @ 2515' TD 2732

229' of 5" Liner @ 2732

1945

1/3 " " " " " "

1/10 " " " " " "

1/17 7" @ 2515

229' of 5" Perf. liner @ 2732

8000 acid

TD 2732

16,779,000 Gas

410# R Pr.

COMPLETED

Pool Name Hugoton
 Map No. 14 Sec. 14 Twp. 30 R. 34W
 Well No. 4 Huxman

United Prod

Company

FIRST REPORT

Contractor


SW NE

SECTION FLAT

Ft. from N. Line

100 Ft. from S. Line

Ft. from E. Line

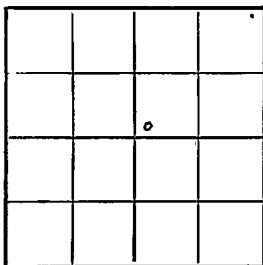100 Ft. from W. LineHaskellLocation X

Rig up

Drilling and Remarks:

RECORD

Cased _____ in., _____ ft.

Sand _____

Gas _____

Oil _____

Total Depth _____

PRODUCTION

1st 24 hrs. Nat. _____

1st 24 hrs. after shot _____

Gas _____ Cu. Ft.

Dry Hole _____

Abandoned _____

Date

OCT 18 1944

19

S. J. LEWIS

Scout

KANSAS

Pool Name HugotonMap No. _____ Sec. 14 Twp. 30 R. 34WWell No. 4 Hugoton


United Prod _____ Company

COMPLETED

Contractor _____

SW NE

SECTION PLAT

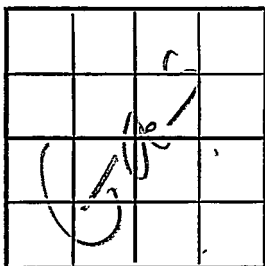

_____ Ft. from N. Line

100 Ft. from S. Line

_____ Ft. from E. Line

100 Ft. from W. Line

Haskell

RECORD

Location _____

Cased _____ in., _____ ft.

Rig up _____

Sand _____

Drilling and Remarks:

Gas _____

7" @ 2515'

Oil _____

229' of 5" Perf. LinerTotal Depth 2732'@ 2732'

PRODUCTION

9000 Bbls Oil

1st 24 hrs. Nat. _____

16,779,000 Gas

1st 24 hrs. after shot _____

Gas _____ Cu. Ft.

Dry Hole _____

Abandoned _____

410 # R 1 1/2

Date

JAN 17 1945

19

S. J. LEWIS

Scout