


SECTION 14 TOWNSHIP 30S RANGE 1W

WELL NO. #1 Williams

COMPANY Brunson Prod. & Explor.

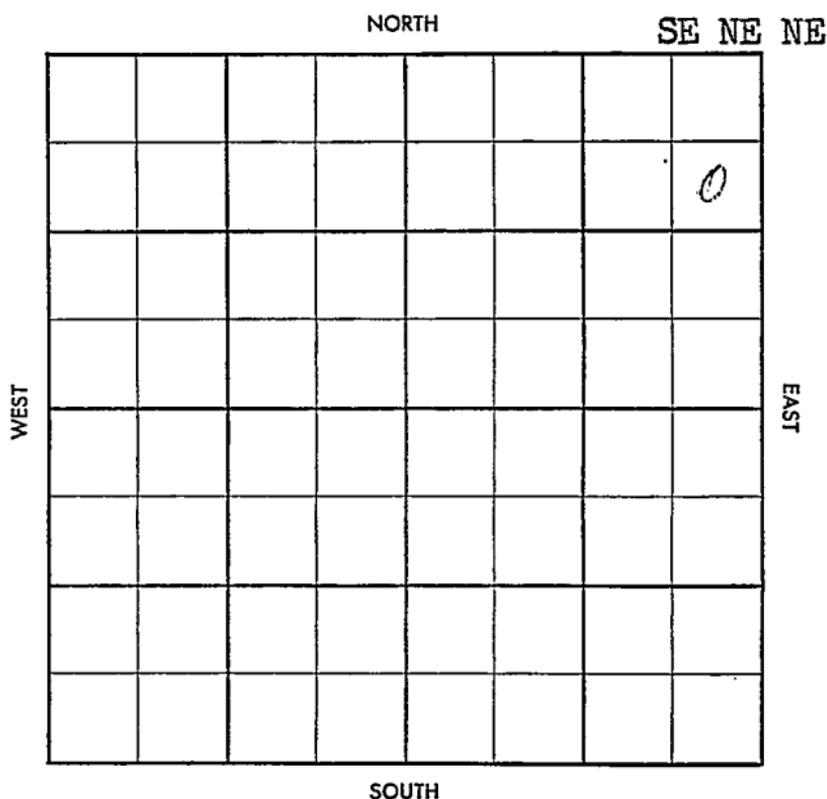

~~2/18~~ ~~2/18~~
~~2/18~~ ~~2/18~~

County Sumner Elev. _____
 Sec. 14 Twp. 30 Rge. 1W
 Company Brunson Prod. & Explor.
 Farm Name Williams No. 1

TOPS	DEPTH	LOG	DATUM
Anh.			
Tp.			
H.			
Tr.			
Dg.			
B.L.			
L.			
K.C.			
B.K.C.			
Ce.			
C.			
M.			
M.			
K.			
Mz.			
Mq.			
V.			
S.			
S.			
A.			
R.			
Pf.			
G.			
T.D.			

Loc. in Sec. SE NE NE
 Geol. _____
 Contr. _____
Co. tools
 Pool _____



Date Comm. _____
Location

Co.
 Lse.
 No.
 Sec.
 T.
 R.

Twp. X Pool X
 Co. X Facet X

S-513-B

County Sumner Elev. 1233DF 1236RB
 Sec. 14 Twp. 30 Rge. 1W
 Company Brunson Prod. & Explor.
 Farm Name Williams No. 1

TOPS	DEPTH	LOG	DATUM	Loc. in Sec.
Anh.				SE NE NE
Tp.				
H.				
Tr.				
Dg.				
B.L.				
L.				
K.C.				Geol.
B.K.C.				Contr.
Ce.				Co. tools
C.				Pool
M.	3423			34Ba
M.				
K.	3793			
Mz.				
Mq.				
V.	sd	3859		
S.				
A.				
R.				
Pf.				
G.				
T.D.	3862			

ABANDONED
 JUN 18 '58

Date Comm. 5-13-58
 Location RAY 21 '58 8" 377 #3292 MAY 28 '58
5" 38.59 WOCT JUN 3 '58 no log
JUN 11 '58 CO JUN 18 '58 3862 \$W
SSO

D-6A