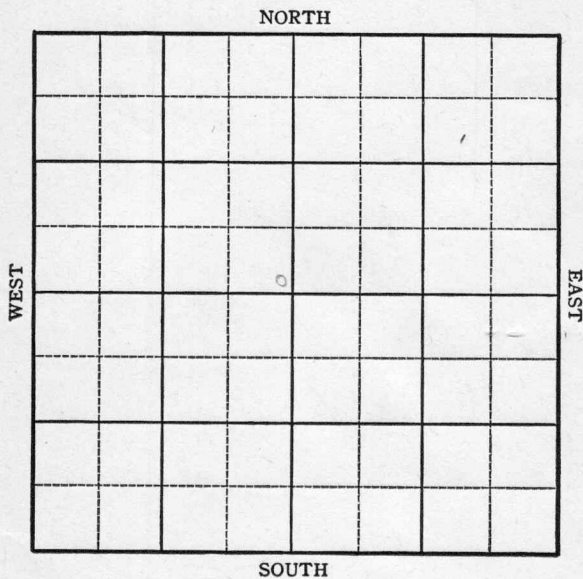


Section 15 Township 30 Range 36WWell No. 1 TeeterCompany United Prod.

KANSAS

Grant County

Sec. 15 Twp. 30 R. 36W

Well No. #1 Teeter Farm

United Prod. Company


Hugoton

 Ft. from N. Line

100 Ft. from S. Line

100 Ft. from E. Line

 Ft. from W. Line

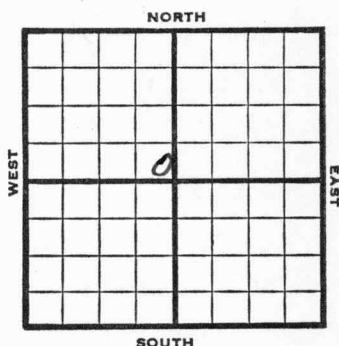

SE NW

1945 Elev. 3020 REPORT

11/28	Drlg. 100'
12/5	Drlg. 1765
12/12	TD 2770 7" @ 2770 RUST
12/20	" "
12/29	" "
1946	
1/10	" "
1/17	" "
1/24	Perf 246 shots 2425-2602' 5000 acid.
1/31	Total of 15000 acid.
2/6	7" @ 2770 Perf. 15,000 acid. TD 2770' 19,300,000 Gas. 393# R Pr.

COMPLETED

KANSAS Kansas Pool Name Hugoton

Sec. 15 Twp. 30 R. 36W
1 Teeter


United Prod.

Company

CORRECTION & FIRST REPORT Contractor

SE NW

SECTION PLAT

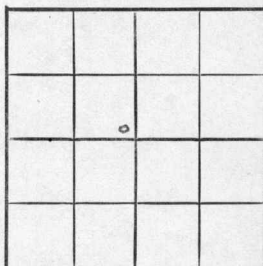

Ft. from N. Line

100 Ft. from S. Line

100 Ft. from E. Line

Ft. from W. Line

Grant County

Location

Rig up

Drilling and Remarks:

reported SW NW

RECORD

Cased _____ in., _____ ft.

Sand _____

Gas _____

Oil _____

Total Depth _____

PRODUCTION

1st 24 hrs. Nat. _____

1st 24 hrs. after shot _____

Gas _____ Cu. Ft.

Dry Hole _____


Abandoned _____

Date

NOV 28 1945 19

S. J. LEWIS Scout

SECTION PLAT

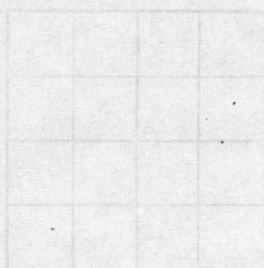

_____ Ft from N. Line
 _____ Ft from S. Line
 _____ Ft from E. Line
 _____ Ft from W. Line

RECORD

Misc. Small Maps

Cards

Tracing

France Map

Scarborough Map

Moody Map

Geological Dept

Moody Plat Book


KANSAS


Pool Name HugotonMap No. Sec. 15 Twp. 30 R. 36WWell No. 1 TeeterUnited Prod. Company

FIRST REPORT

Contractor

SW NW

SECTION PLAT

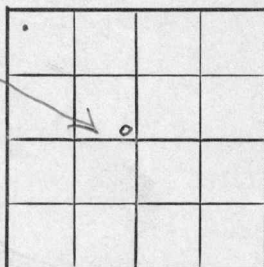 Ft. from N. Line100 Ft. from S. Line100 Ft. from E. Line Ft. from W. Line

Grant County

Location Rig up

Drilling and Remarks:

100'

RECORD

Cased in., ft.Sand Gas Oil Total Depth

PRODUCTION

1st 24 hrs. Nat. 1st 24 hrs. after shot Gas Cu. Ft.Dry Hole Abandoned

Date

NOV 28 1945 19S. J. LEWIS

Scout

check description
advised
same



no wall

Misc Small Maps _____
Cards *Barack* _____
Tracing _____
France Map _____
Scarborough Map ~~_____~~
Pierce Map _____
Geological Dept. _____
Pierce Plat Book _____

KANSAS

Kansas

Pool Name

Hugoton

Map No. None Sec. 15 Twp. 30 R. 36WWell No. 1 Teeter

United Prod.

Company

COMPLETE

Contractor

SE NW

E13020
SECTION PLAT

Ft. from N. Line

100

Ft. from S. Line

100

Ft. from E. Line

Ft. from W. Line

Grant County

Location

Rig up

Drilling and Remarks:

7102770

Prof

5000 acid

19,300,000 Gas

093 R

RECORD

Cased in., ft.

Sand

Gas

Oil

Total Depth 2770

PRODUCTION

1st 24 hrs. Nat. 1st 24 hrs. after shot Gas Cu. Ft.Dry Hole Abandoned


Date

FEB 6 1946 19

S. J. LEWIS

Scout

SECTION PLAT

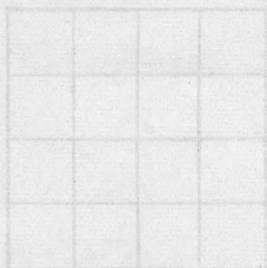

Handwritten signature/initials across the middle of the page.

Misc. Small Maps	☒
Cards	☒
Tracing	☐
France Map	☐
Scarborough Map	☒
Moody Map	☐
Geological Dept.	☐
Mind' Plat Book	☐