


Section 15 Township 30 Range 32W

Well No. 1 John Proksch

Company Stanolind

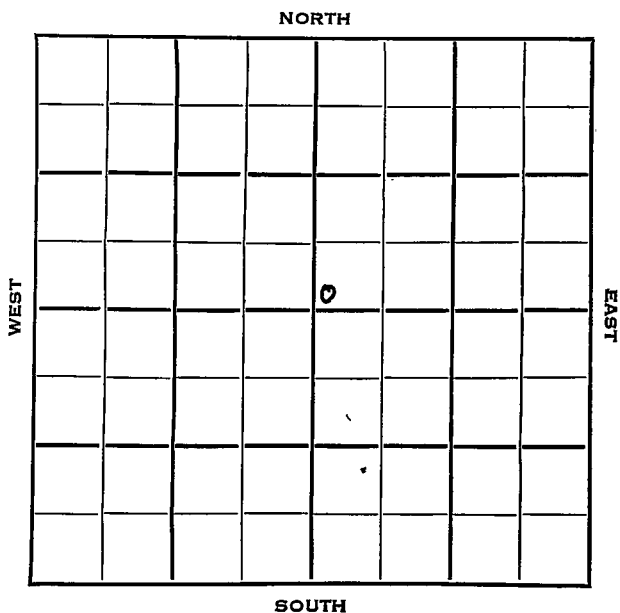

SEC.	TWP.	R.
15	30	32 W

WELL NO. # 1 John P roksch FARM

COMPANY Stanolind

CONTRACTOR

Hugoton Pool


_____ Ft. from N. Line

150 _____ Ft. from S. Line

_____ Ft. from E. Line

150 _____ Ft. from W. Line

SW SW NE

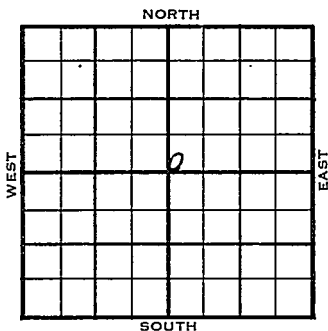

	ELEVATION	REPORT
1954	2883'	

3/10 Location
 3/17 8" @ 724'
 Drlg 1725'
 3/24 RTD 2735'
 Her. 2655', Kr. 2697'
 5" @ 2697'
 3/31 WOCT.
 4/21 Spud 3-14-54
 Gas Well
 TD 2735'
 8" @ 724'
 Her. 2655', Kri 2697',
 TD 2735'
 5" @ 2697'
 CO to 2735
 2500 A 72/ 2660-72 24/ 2676-80
 2000 A 7000 A 4000 A CO to 2735
 Comp 5,384,000 gas 390#

COMPLETED

