


Section 15 Township 30 Range 1W

Well No. #2 Chitwood

Company Sullivan et al

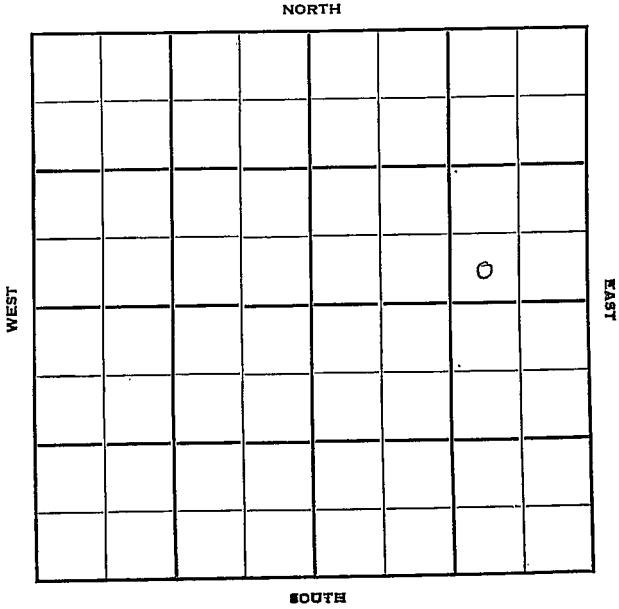



Sec. 15 Twp. 30 R. 1-W

Well No. #2 Chitwood Farm

Sullivan et al Company

Williams Contractor

Zyba


_____ Ft. from N. Line

330 Ft. from S. Line

990 Ft. from E. Line

_____ Ft. from W. Line

SW SE NE

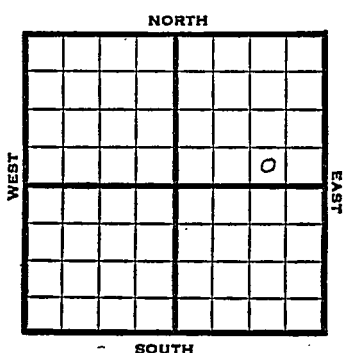

1950

Elev 1246' REPORT

10/18

Dr1g 3154

11/29

Spud 9028-50
10" @ 290
Simp 3874
5" @ 3874
TD 3894
SSO
Hydrafrac
FU 2000' oil
12 hr S/70 bo 8 hr
Comp 95 bopd 4 bwpd
Completed

COMPLETED

County Sumner State Kansas

Sec. 15 (Blk. Twp.) 30 (Sur. Rge.) 1W Map No.

Operator Sullivan et al.

Well No. 2 Farm Chitwood

Elev. _____ Location SW SE NE

330 Ft. From S Line NE

990 Ft. From E Line Quarter

lst. Report OCT 18 1950

Completion _____

Remarks _____

Williams - Contr.

Spudding Date _____

Drlg. Data Zyba Pool

drlg. 3154

