


KANSAS

Section 15 Township 30 Range 1W

Well No. 3 Snyder

Company M J Sullivan et al
Zyba

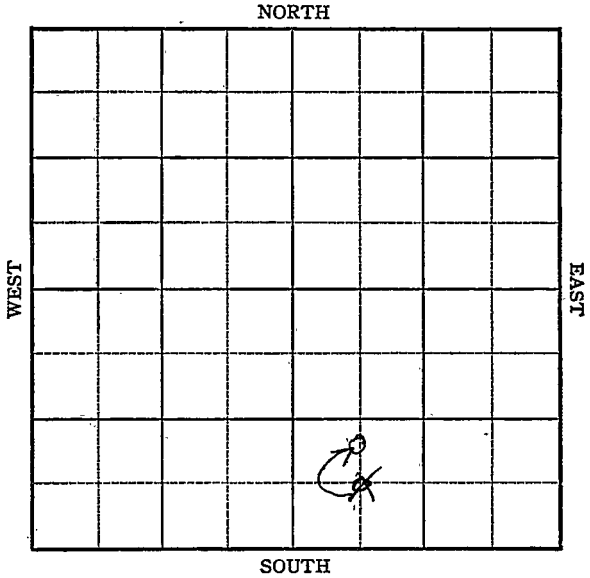

KANSAS Summer



Sec. 15 Twp. 30 R. 1W

Well No. #3 Snyder Farm

M. J. Sullivan et al Company


Zyba Pool (Williams, Cont.) NORTH

_____ Ft. from N. Line

660° 990 Ft. from S. Line

_____ Ft. from E. Line

660° Ft. from W. Line

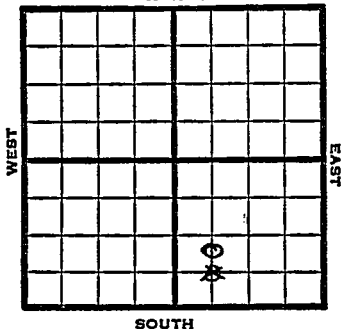

~~C SW SE~~
CNL Sullivan

1949 Elev. 1255' REPORT

- 5/18 8" @ 307'
- 5/25 Drlg. 435'
- 6/1 Miss 3473'
Drlg. 3690'
- 6/7 Simpson 3874
TD 3880
5" @ 3874'
- 6/15 TD 3889'
Swb 33 bbls oil PH - 8 hrs.
- 6/22 Simp 3874'
5" @ 3874'
Pump 278 oil Pot.
Gr. 49°
TD 3889'

COMPLETED

Kansas

Map No. _____ Sec. 15 Twp. 30 R. 1WWell No. 3 SnyderM. J. Sullivan et al. CompanyWilliams Contractor

C SW SE

FIRST REPORT
SECTION PLAT

_____ Ft. from N. Line

660 Ft. from S. Line

_____ Ft. from E. Line

660 Ft. from W. Line

		o	

Summer County

Location _____

Rig up _____

Drilling and Remarks:

8" @ 307

RECORD

Cased _____ in., _____ ft.

Sand _____

Gas _____

Oil _____

Total Depth _____

PRODUCTION

1st 24 hrs. Nat. _____

1st 24 hrs. after shot _____

Gas _____ Cu. Ft.

Dry Hole _____

Abandoned _____

Date

MAY 18 1949 19S. J. LEWIS

Scout

Map No. K38 Sec. 15 Twp. 30 R. 1W

Well No. 3 Snyder

M. J. Sullivan et al. Company

COMPLETE

Contractor

C N L SW SE

E 1, 1255

SECTION PLAT

_____ Ft. from N. Line

990 Ft. from S. Line

_____ Ft. from E. Line

660 Ft. from W. Line

		0	

Summer County

RECORD

Location _____

Cased _____ in., _____ ft.

Rig up _____

Sand _____

Drilling and Remarks:

Gas _____

Sump 3874

Oil _____

5" 63874

Total Depth 3885

Prod 275 cu ft

PRODUCTION

1st 24 hrs. Nat. _____

1st 24 hrs. after shot _____

Gas _____ Cu. Ft.

Dry Hole _____

Abandoned _____

Date _____

JUN 22 1949

S. I. LEWIS Scout