


Section 15 Township 30 Range 1 W

Well No. # 4 Snyder SWD

Company Tom Sullivan

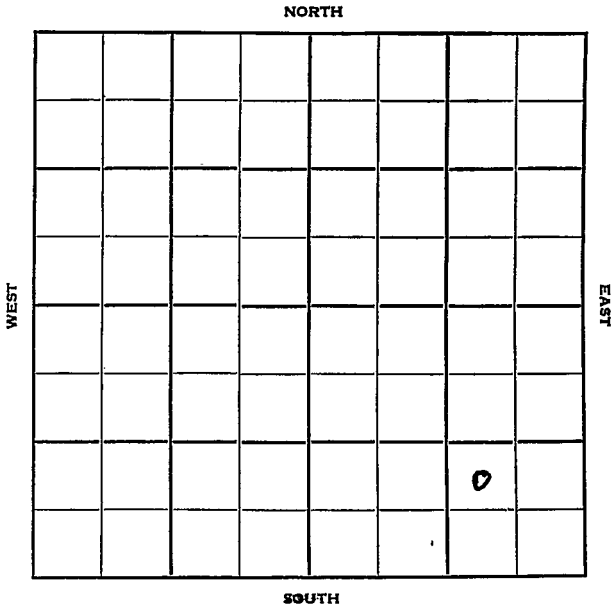

Sec. 15 Twp. 30 R. 1W

Well No. #4 Snyder SWD Farm

Tom Sullivan Company

Contractor


Ft. from N. Line

990 Ft. from S. Line

990 Ft. from E. Line

Ft. from W. Line

NW SE SE

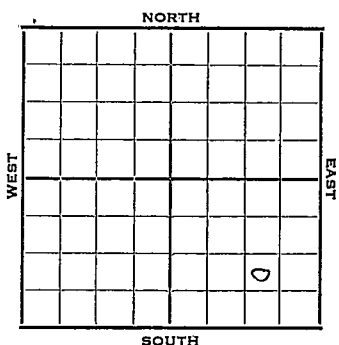

1952

Elev. - REPORT

6/11 TD 2690'

6/18 SWD well TD 2690' 10" @ 300
Stal. 2545' 5" @ 2690'
190/2553-2656'
Comp. SWD

ABANDONED

