

O.W.W.O.

KANSAS

FORM 51 5M 1-42 PETROL

Kingman


Section 15 Township 30 Range 7W

Well No. #1 Kiner Estate

Company Wilcox Oil & Gas

~~Wildcat~~

NORTH

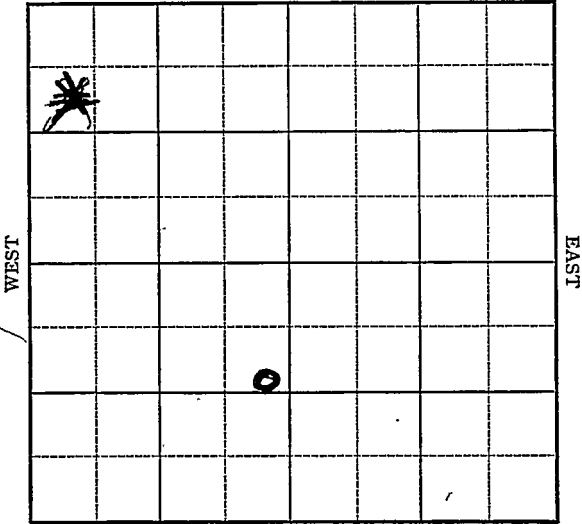

SOUTH

Sec. 15 Twp. 30 R. 7WWell No. #1 Kinert Estate Farm


Wilcox Oil & Gas Company

~~Gilchrist~~
(Wildcat)(D+M ϕ - Cont'd) NORTH990 Ft. from N. Line

Ft. from S. Line

330 Ft. from E. Line

Ft. from W. Line

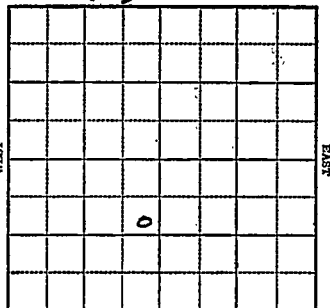

Elev. 1457

SE NE SW

SOUTH

1942

R E P O R T

11/4 Location

11/11 Derrick

11/18 "

11/24 "

12/2 10" @ 234
WOC12/9 Ft. Riley 1435
Base flower 1655
Drlg. 233012/16 Tarkio 2380
Topeka 2710
Drlg. 3280

12/22 Drlg. 4010'

12/29 Miss. 4127
Drlg. 44901943
1/6 Arb. 4674
Viola 4505
Simp. 4535
No shows
T.D. 48074127
1457
2670

ABANDONED

OVER

1955
12/14

O.W.W.O.

OTD 4807'
BL 3321' Miss 4127', Simp. 4535'
Arb. 4674'.
CO to 4807' Rng Schl.
TD 4807'

12-21 D & A
L. 3321
M. 4127-4120
K. 4410
Chata 4497
S. 4535-4530
A 4674-4665
TD 4807'

3 3 21
14 57

18 64

ABANDONED

KANSAS **Kingman**
 Map No. 36 Sec. 15 Twp. 30 R. 7W

Well No. 1 Kinert Estate

Wilcox Oil & Gas Company

FIRST REPORT Contractor

SE NE SW

SECTION PLAT


990 Ft. from N. Line

_____ Ft. from S. Line

330 Ft. from E. Line

_____ Ft. from W. Line

WILDCAT

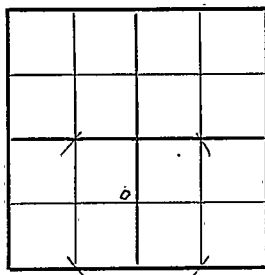

Location XXX

Rig up _____

Drilling and Remarks:

RECORD

Cased _____ in., _____ ft.

Sand _____

Gas _____

Oil _____

Total Depth _____

PRODUCTION

1st 24 hrs. Nat. _____

1st 24 hrs. after shot _____

Gas _____ Cu. Ft.

Dry Hole _____

Abandoned _____

Date

NOV 4 1942₁₉

S. J. LEWIS Scout

Misc. Small Maps *Qma*
Cards *Charlene*
Tracing *MB*
France Map *✓*
Scarborough Map *✓*
Moody Map *✓*
Geological Dept. *✓*
Moody Plat Book *✓*

KANSAS
 Map No. 27 Sec. 15 Twp. 30 R. 7W

Well No. 1 Kinert Estate

Wilcox Oil & Gas Company

ABANDONED Contractor

SE NE SW


SECTION PLAT

990 Ft. from N. Line

 Ft. from S. Line

330 Ft. from E. Line

 Ft. from W. Line

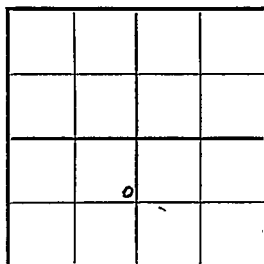

WILDCAT

Location

Rig up

Drilling and Remarks:

Per 4674

V. 17 4505

Simp 4535

No. 12000

RECORD

Cased in., ft.

Sand

Gas

Oil

Total Depth 4902

PRODUCTION

1st 24 hrs. Nat.

1st 24 hrs. after shot

Gas Cu. Ft.

Dry Hole

Abandoned

Date

JAN 6 1943 19 S. J. LEWIS Scout

misc. Small Maps *One*

Cards *One*

Tracing *MB*

Trance Map *MB*

Scarborough Map *MB*

Body Map *MB*

Biological Dept. *MB*

Body Plat Book *MB*

O.W.W.O.

FORM 513 REV. SUNRAY

OWWO

County Kingman Elev. 1457
 Sec. 25 Twp. 30 Rge. 7W
 Company Wilcox Oil
 Farm Name Kennert No. 1

TOPS	DEPTH	LOG	DATUM	Loc. in Sec.
Anh.				SE NE SW
Tp.				
H.				
Tr.				
Dg.				
BL.	3321			
L.				Geol.
K.C.				Contr.
B.K.C.				D & M
Ce.				Pool
C.	4127			Gilchrist
M.				
M.				
K.				
Mz.				
Me.				
V.	4535			
S.				
S.	4674			
A.				
R.				
Pe.				
G.				
T.D.	4807			

FIRST REPORT

DEC 14 '55

Date Comm.

CO to 4807 rng. Schl.

21

DEC 29 1955

M. M.

OWWO

County Kingman Elev. 1157
 Sec. 15 Twp. 30 Rge. 7W
 Company Wilcox Oil
 Farm Name Kennert No. 1


TOPS	DEPTH	LOG	DATUM	Loc. in Sec.
Anh.				SE NE SW
Tr.				
Dg.				
Bl.				
L.	3321		1864	Geol.
K.C.				Contr.
B.K.C.				D & M
Ce.				Pool
C.				Gilchrist
M.	4127	4120	2663	
M.				
K.		4410	2953	
Mz. <u>Chato</u>		4497	3040	
Me.				
V.				
S.	4535	4530	3073	
S.				
A.	4674	4665	3208	
R.				
Pe.				
G.				
T.D.	4807	4806		

DEC 21 1955

Date Comm.

CO to 4807

D & A

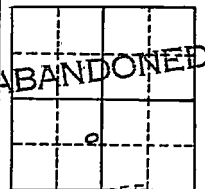

JAN 4 1956

R. G.