Kingman KANSAS

SECTION 15 TOWNSHIP 30 RANGE 7 W

WELL NO. #2 Kinert Est.

COMPANY Wilcox Oil

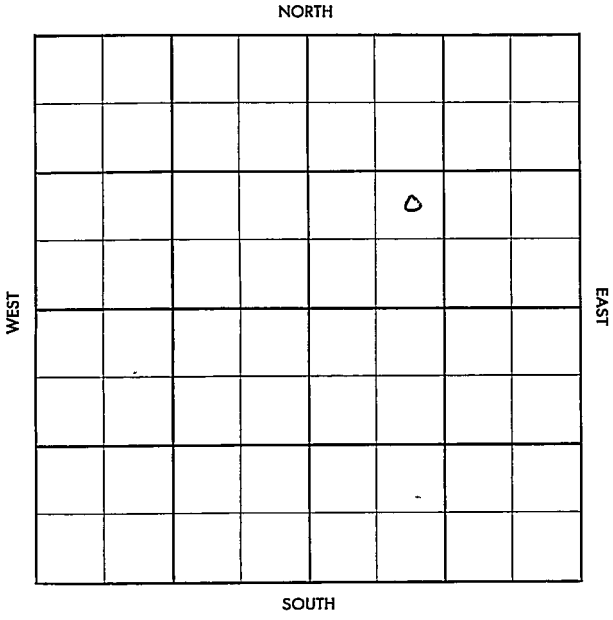

FORM 504-3 SUNRAY

Kingman

SEC.	TWP.	RANGE
15	30	7W

KANSAS

WELL NO.

#2 Kinert Est.

FARM

COMPANY

Wilcox Oil

CONTRACTOR

D & M Drlg.

Gilchrist

_____ Ft. from N. Line

_____ Ft. from S. Line

_____ Ft. from E. Line

_____ Ft. from W. Line

NE SW NE

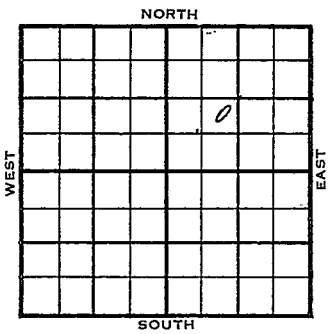

1956	ELEVATION REPORT
1-5	Comm. 12-31-55 8" @ 156/200 Drlg. 1625

DX-78

FORM 513 REV. SUNRAY

County Kinfman Elev.

Sec. 15 Twp. 30 Rge. 7W

Company Wilcox Oil

Farm Name Kinert Est. No. 2

TOPS	DEPTH	LOG	DATUM
Anh.			
T.P.			
H.			
Tr.			
Dg.			
B.L.			
L.			
K.C.			
B.K.C.			
Ce.			
C.			
M.			
M.			
K.			
Mz.			
Mq.			
V.			
S.			
S.			
A			
R.			
P€.			
G.			
T.D.			

Loc. in Sec. NE SW NE

Geol.

Contr. D & M Drlg.

Pool Gilchrist

JAN 5 '56

O

FIRST REPORT

Date Comm. 12-31-55

8" @ 156/200 drlg. 1625

Co. Lse. No. Sec. T. R.

JAN 9 1956

R. G.

FORM 513 REV. SUNRAY

County Kingman Elev. 1429

Sec. 15 Twp. 30 Rge. 7W

Company Wilcox Oil

Farm Name Kinert Est. No. 2

TOPS	DEPTH	LOG	DATUM
Anh.			
Tp.			
H.		3038	
Tr.			
Dg.			
Bl.			
L.		3258	1829
K.C.	3673		2244
B.K.C.			
Ce.		3969	2540
C.			
M.		4077	2648
M.			
K.			
Mr.			
Ma.			
V.			
S.			
S.			
A.			
R.			
PC.			
G.			
TD.	4180		

Loc. in Sec. NE SW NE

Geol.

Contr. D & M Drlg.

Pool Gilchrist

COMPLETE

FEB 15 1956

Date Comm. 12-31-55

8" @ 156/200 drlg. 1625 JAN 11 '56 Ø 3350

JAN 16 '56 5 1/2 4179 MICT JAN 25 '56 CO

20/3715-20 tst SSO&G @ 15

Flw 18 Boph 6 hrs 21/64" ch.

CP 130 Flw 17 Boph no/w 2

hrs 18/64" ch FCP 128 2" Tbg

Flw 40 Boph 6 hrs FEB 1 '56 w o pot

FEB 8 '56 FEB 15 '56 Ph Flw 516 Bopd

no wtr grav 39°



FEB 2 7 1956
R. G.