


Section 15 Township 30 Range 39-W

Well No. #1, Nicholas "B"

Company Stanolind Oil and Gas Company

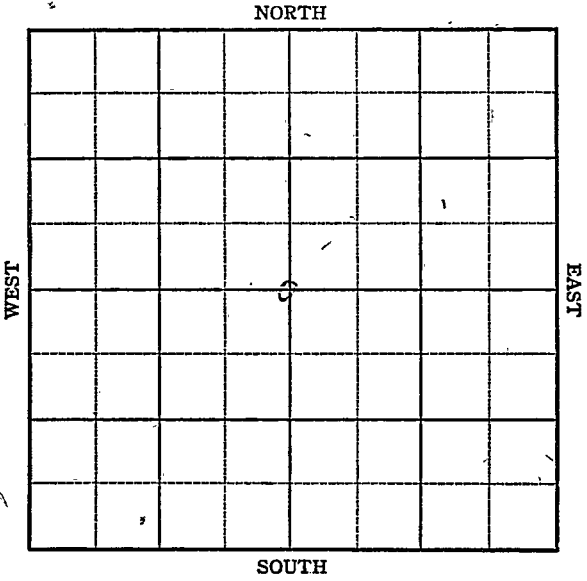

Sec. 15 Twp. 30 R. 39~~W~~

Well No. #1, Nicholas "B" Farm

Stanolind Oil and Gas Co. Company


Hugoton Pool

2640' Ft. from N. Line

\_\_\_\_\_ Ft. from S. Line

2640' Ft. from E. Line

\_\_\_\_\_ Ft. from W. Line

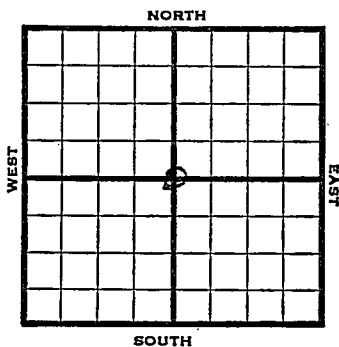

C Section

1946 Eléva 3175' REPORT

12/11 8" @ 604'  
WOC.

12/17 TD 2560'  
5" @ 2525, RUST

1947

1/2 5" @ 2525'  
TD 2560'  
Perf  
16500 Acid  
3,320,000 Gas  
329# RPR

**COMPLETED**

Map No. \_\_\_\_\_ Sec. 15 Twp. 30 R. 39W

Well No. 1 Nicholas "B"

Stanolind Company

**FIRST REPORT**

Contractor

C Sec.

**SECTION PLAT**


2640 Ft. from N. Line

\_\_\_\_\_ Ft. from S. Line

2640 Ft. from E. Line

\_\_\_\_\_ Ft. from W. Line

Stanton County

**RECORD**

Location \_\_\_\_\_

Cased \_\_\_\_\_ in., \_\_\_\_\_ ft.

Rig up \_\_\_\_\_

Sand \_\_\_\_\_

Drilling and Remarks:

Gas \_\_\_\_\_

8" @ 604 WOC

Oil \_\_\_\_\_

Total Depth \_\_\_\_\_

**PRODUCTION**

1st 24 hrs. Nat. \_\_\_\_\_

1st 24 hrs. after shot \_\_\_\_\_

Gas \_\_\_\_\_ Cu. Ft.

Dry Hole \_\_\_\_\_

Abandoned \_\_\_\_\_

Date

DEC 1 1 1946 19

S. J. LEWIS Scout

# KANSAS

Form 26 200 Bks. 10-46 Petrol

Hugoton Pool

Kansas

Map No. \_\_\_\_\_ Sec. 15 Twp. 30 R. 39WWell No. 1 Nicholas "B"

\_\_\_\_\_ Stanolind \_\_\_\_\_ Company

**COMPLETED**

Contractor


C Sec. \_\_\_\_\_

*E13175*  
**SECTION PLAT**\_\_\_\_\_ 2640 Ft. from N. Line

\_\_\_\_\_ Ft. from S. Line

\_\_\_\_\_ 2640 Ft. from E. Line

\_\_\_\_\_ Ft. from W. Line

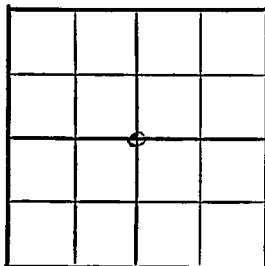

Stanton County

Location \_\_\_\_\_

Rig up \_\_\_\_\_

Drilling and Remarks:

*51 @ 2525'*  
*Prof.*  
*16500 acid*  
*3,320,000 Gas*

**RECORD**

Cased \_\_\_\_\_ in., \_\_\_\_\_ ft.

Sand \_\_\_\_\_

Gas \_\_\_\_\_

Oil \_\_\_\_\_

Total Depth 2570**PRODUCTION**

1st 24 hrs. Nat. \_\_\_\_\_

1st 24 hrs. after shot \_\_\_\_\_

Gas \_\_\_\_\_ Cu. Ft.

Dry Hole \_\_\_\_\_

Abandoned \_\_\_\_\_

*319 # R.P.*

Date

JAN 2 1947 19S. J. LEWIS Scout