


Stanton

KANSAS

Section 15 Township 30 Range 40W

Well No. 1 Strong

Company Kansas Natural

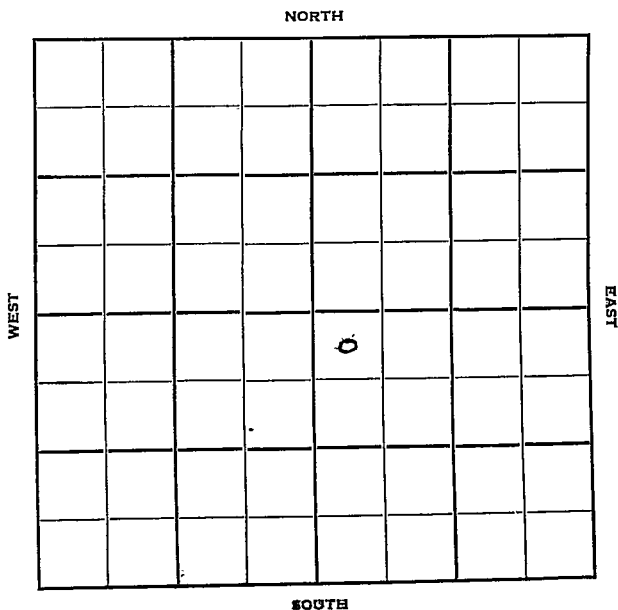

Stanton **KANSAS**Sec. 15 Twp. 30 R. 40WWell No. #1 Strong FarmKansas Natural Company

Contractor


150 Ft. from N. Line

Ft. from S. Line

Ft. from E. Line

150 Ft. from W. Line

NW SE

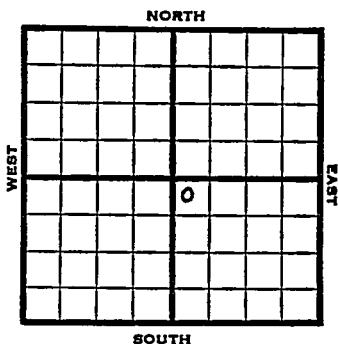

1952 Elev. 3271' REPORT

12/17 Kri 2244, Win 2298

7" @2296

Td 2298'

Spud 12-9-52

12/25 TD 2298

1/1 TD 2298

1/8 TD 2298

1/22 Testing

1/28 Spud 12-9-52 Gas well TD 2302'

Kri. 2244' Win. 2298' 7" @ 2296

TD 2298 DD 2302 SP 2294 72/2250-6

62 DP to 2302 SP 2248'

84/2234-48 3000 A CO to 2302

2000 A

Comp. 4,765,000 gas

COMPLETED

J. G. McGEHEE

Scout Cards	_____
Land Small Map	_____
Land Wall Map	_____
Tracings	_____
Frances Map	_____
Pierce Map	_____
Misc.	_____

Handwritten signature 19 1952

County Stanton State Kansas

Sec. 15 (Blk. Twp.) 30 (Sur. Rge.) 4 OW Map No.

Operator Kansas Natural

Well No. 1 Farm Strong

Elev.	3271	Location	NW SE
-------	------	----------	-------

COMPLETE

0

150 Ft. From N Line SE

150 Ft. From W Line Quarter

1st. Report

Completion JAN 28 1953

Remarks

Spudding Date 12-9-52

Drig. Data Gas well TD 2302

Kri. 2244 Win. 2298 7" @ 2296

TD 2298 DD 2302 SP 2294 72/ 2250-62

DP to 2302 SP 2248 84/ 2234-48

3000 A CO to 2302 2000 A

Comp. 4,765,000 gas

Scout Cards	mm
Land Small Map	
Land Wall Map	39
Tracings	
France Map	
Pierce Map	
Misc.	

FEB 4 1953

Drig. Date