


Section 16 Township 30 Range 13W

Well No. 1 Lemoh "D"

Company Lion Oil

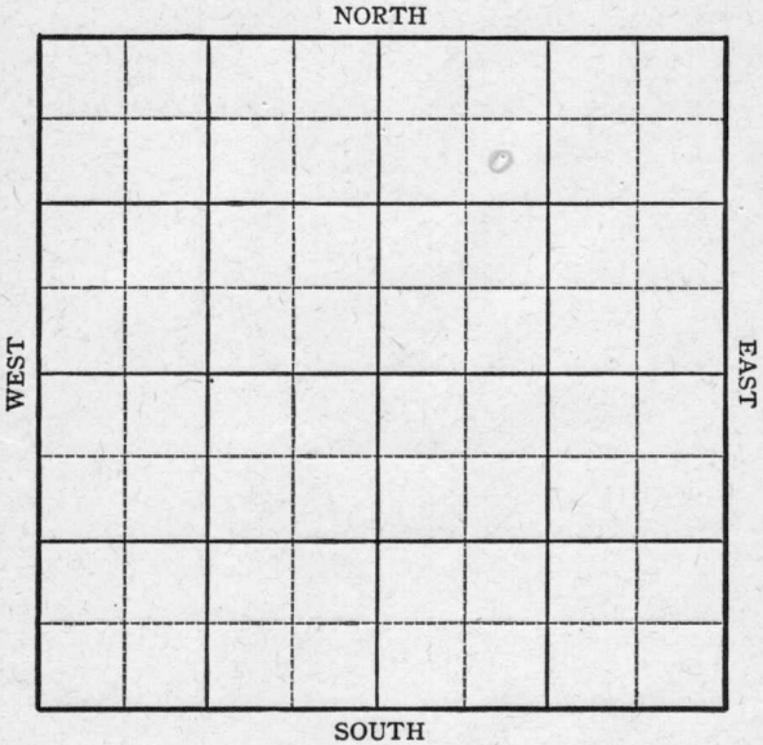

Sec. 16 Twp. 30 R. 13-W

Well No. #1 Lemon "D" Farm


Lion Oil Company

990 Ft. from N. Line

_____ Ft. from S. Line

_____ Ft. from E. Line

990 Ft. from W. Line

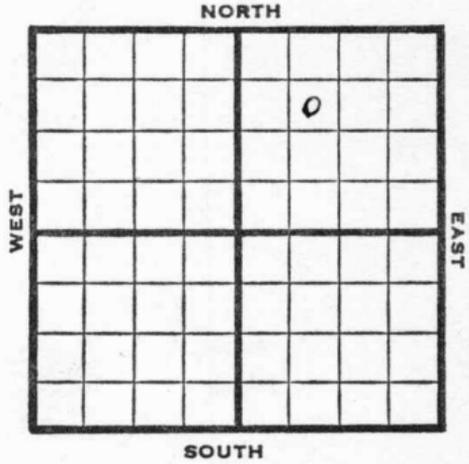

SE NW NE

1945

Elev. 1831

REPORT

9/12 Location

9/19 RUR

9/26 "

10/3 9" @ 921' WOC

10/10 Drlg. 2423'

10/17 Lans. 3907

Drlg. 4010'

10/24 Miss. 4369

Viola 4484

Drlg. 4520'

10/31 Arb. 4656

TD 4737'

ABANDONED

KANSAS Kansas Pool Name Marjorie Pool

Map No. 92 Sec. 16 Twp. 30 R. 13W

Well No. 1 Lemon "D"

Lion Oil Company

ABANDONED Contractor

E. 1, 1831

SE NW NE

SECTION PLAT

990 Ft. from N. Line

_____ Ft. from S. Line

_____ Ft. from E. Line

990 Ft. from W. Line

		0	

Barber County

Location _____

Rig up _____

Drilling and Remarks:

cut 4656

RECORD

Cased _____ in., _____ ft.

Sand _____

Gas _____

Oil _____

Total Depth 4737

PRODUCTION

1st 24 hrs. Nat. _____

1st 24 hrs. after shot _____

Gas _____ Cu. Ft.

Dry Hole _____

Abandoned _____

Date

OCT 3 1 1945 19

S. J. LEWIS Scout

KANSAS Pool Name Marjorie
Kansas

Map No. 92 Sec. 16 Twp. 30 R. 13W

Well No. 1 Lemon "D"

Lion Oil Company

FIRST REPORT Contractor

SE NW NE


SECTION PLAT

990 Ft. from N. Line

_____ Ft. from S. Line

_____ Ft. from E. Line

990 Ft. from W. Line

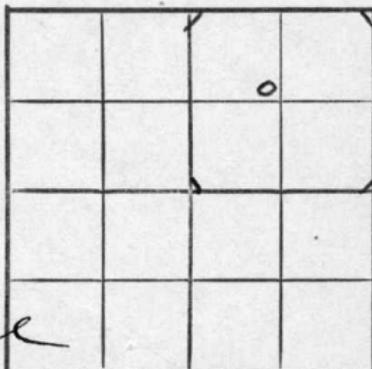

close our acreage

Barber County

Location X

Rig up _____

Drilling and Remarks:

ffff

RECORD

Cased _____ in., _____ ft.

Sand _____

Gas _____

Oil _____

Total Depth _____

PRODUCTION

1st 24 hrs. Nat. _____

1st 24 hrs. after shot _____

Gas _____ Cu. Ft.

Dry Hole _____

Abandoned _____

Date

SEP 12 1945

19

S. J. LEWIS

Scout