


Section 16 Township 30 Range 9 W

Well No. # 1 Turley

Company Time Pet.

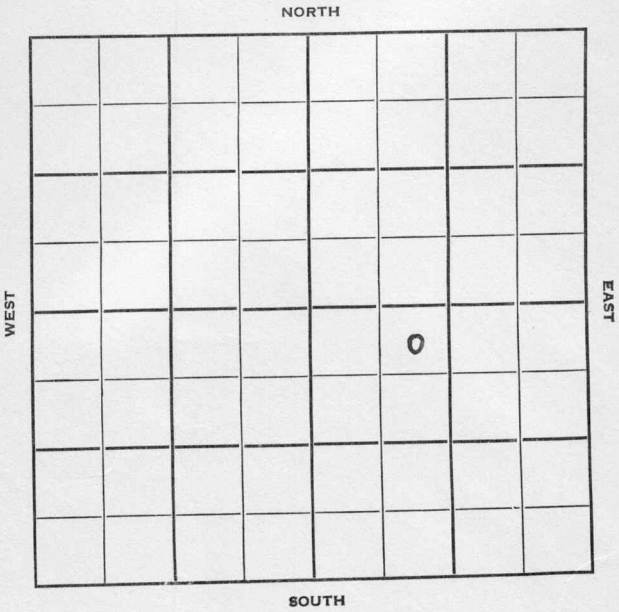

Sec. 16 Twp. 30 R. \_\_\_\_\_

Well No. #1 Turley Farm \_\_\_\_\_

Time Pet. \_\_\_\_\_ Company \_\_\_\_\_

Stearns Drlg. - Contr. Contractor \_\_\_\_\_


Wildcat

330' Ft. from N. Line

\_\_\_\_\_ Ft. from S. Line

\_\_\_\_\_ Ft. from E. Line

990' Ft. from W. Line

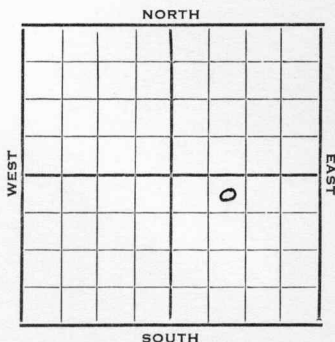

NE NW SE

1952

Elev. - REPORT

- 5/14 Cellar & Pits
  - 5/21 "
  - 5/28 "
  - 6/11 "
  - 6/18 Abandoned Location
- ABANDONED**



