
DX 78-1

Kingman County, Kansas

Section 16 Township 30S Range 8W

Well No. #1 Wells

Company Sohio Pet

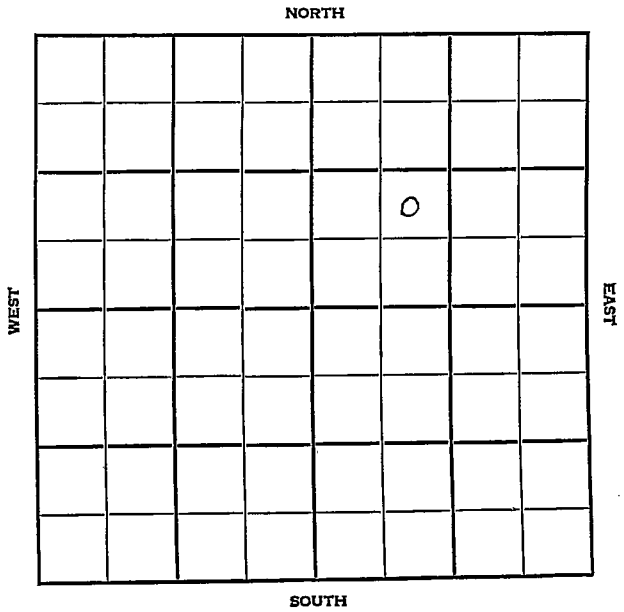

HOT FILE

Kingman KANSAS


SEC.	TWP.	R.
16	30	8 W

WELL NO. # 1 Wells FARM

COMPANY Sohio Pet.

CONTRACTOR Garvey

NW Spivey

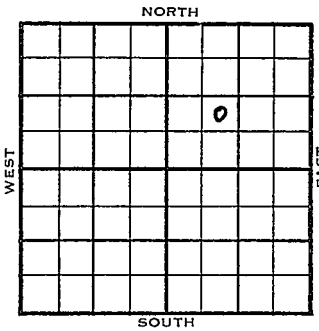

_____ Ft. from N. Line

_____ Ft. from S. Line

_____ Ft. from E. Line

_____ Ft. from W. Line

NE SW NE

SDX Lse - 3/8 Mile

1955	ELEVATION 1506' REPORT
8/31	MIR
9-8	Spud 9-1-55, 8 5/8" @ 303/200, crooked hole, skid rig 25' south, spud 9-3-55 8 5/8" @ 301/200, drlg.1665'
9-15	Heeb. 3163, Doug. sh. 3196, Lans. 3390 Drlg. 2500
9-21	DST 4125-55 open 1 hr.,rec 105,000 cf dec. 30' gcm BHP 1540# 20" DST 4155-77 op 1 hr. rec. 12' vsgcm BHP 0 20" D & A

Tops:	Depth	Log
H.	3163-	3166
Sh	3196	3198
L.	3390	3386
Chat	4140	4140
Li		4155

T.D. 4300'

ABANDONED

DX-78

FORM 513 REV. SUNRAY

County Kingman Elev. 1506

Sec. 16 Twp. 30 Rge. 8W

Company Sohio Pet.

Farm Name Wells No. 1

TOPS	DEPTH	LOG	DATUM
Anh.			
T.P.			
H.	3163	3166	1660
Tr.			
Dg. Sh	3196	3198	1692
Bl.			
L.	3390	3386	1880
K.C.			
B.K.C.			
Ce.			
C.			
M. Chat	4140	4140	2634
M. Li		4155	2649
K.			
Mz.			
Mq.			
V.			
S.			
S.			
A			
R.			
P€.			
G.			
T.D.	4300		

Loc. in Sec. NE SW NE

Geol.

Contr. Garvey

Pool NW Spivey

ABANDONED

Date Comm. 9/1/55 SEP 2 1 1955

8 58" 303 w/200 DST 4125-55 open 1 hr.

Rec. 105,000 cf dec. 30' gcm BHP 1540# 20"

DST 4155-77 open 1 hr. Rec. 12' vsgcm BHP

0 20"

D & A

Co. Lse. No. Sec. T. R.

FORM 513 REV. SUNRAY

County Kingman Elev.

Sec. 16 Twp. 30 Rge. 8W

Company Sohio Pet.

Farm Name Wells No. 1

TOPS	DEPTH	LOG	DATUM
Anh.			
T.P.			
H.			
Tr.			
Dg.			
B.L.			
L.			
K.C.			
B.K.C.			
Ce.			
C.			
M.			
M.			
K.			
Mz.			
Mq.			
V.			
S.			
S.			
A			
R.			
P€.			
G.			
T.D.			

Loc. in Sec. NE SW NE

Geol.

Contr. Gurney

Pool Wm. Spivey

AUG 31 '55 0

FIRST REPORT

3/8mile

Date Comm.

M I R

Co. Lse. No. Sec. T. R.