
Haskell KANSAS

SECTION 16 TOWNSHIP 30S RANGE 34W

WELL NO. #3 Stevens

COMPANY United Prod.

NORTH C SW SW

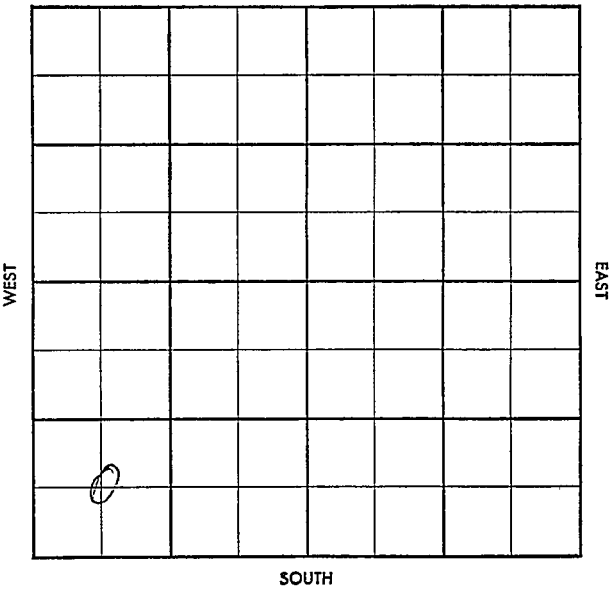

FORM 504-3 SUNRAY

S-513-A

CO. ~~Haskell~~ ELEV.

SEC. 16 TWP. 30 RGE. 34W

COMPANY United Prod. NO. 3

FARM ~~Stevens~~

LOC. C SW SW

GEOL.

CONTR. Rine Drlg. tools

POOL ~~Satanta~~

SPUD 9-28-57

stuck @ 1368 (6050' test)

FIRST REPORT

OCT 2 '57

CO. LSE. NO. SEC. TWP. RGE.

S-513-A

CO. Haskell ELEV. 2922

SEC. 16 TWP. 30 RGE. 34W

COMPANY United Prod. NO. 3

COMPLETE

0 NOV 20 57

FARM Stevens

LOC. C SW SW

Log

almer 3173	
Wdb 3271	
Shaw 3540	
Hb 3990	
TR 4064	
Dgsh 4138	
Lsg 4207	
Man 4810	
Ce 4986	
Monsh 5343	

GEOL.

CONTR. Rine Drlg. tools

POOL Satanta

SPUD 9-28-57

stuck @ 1368 (6050' test)

13" 568/600

Ⓟ 2220

8" 1775/1750

Ⓟ 4190

Mon 5324

DST 5371-95 60" G/8"
ga 90 MCF/10" TSTM/20"
rec 2190 OIL 38° FP 155
-305 BHP 1215/20" TD
5600 mud log

Pon 5366-76 5534-39 Chest
5573? LTD 5600 RTD 5800
DST 5728-5800 45" 60' M
NS FP 30-30 BHP 1110/120"

5½" 5460/1750 MCT
Q 5414 56/5367-81 $ 1's
Bopdh nw nt (½) $ 1 Bopdh
nw frac 5X10 $ & Ⓟ 10
193 BO nw 23 hrs Ⓟ
NOV 20 57 Ⓟ 211 BO 39° gr
nw 24 hrs
SI No Market

MDK 5367-81