Haskell


FORM 51 5M BRIX

KANSAS

Section 16 Township 30 Range 34W

Well No. #2 Stevens

Company United Prod.

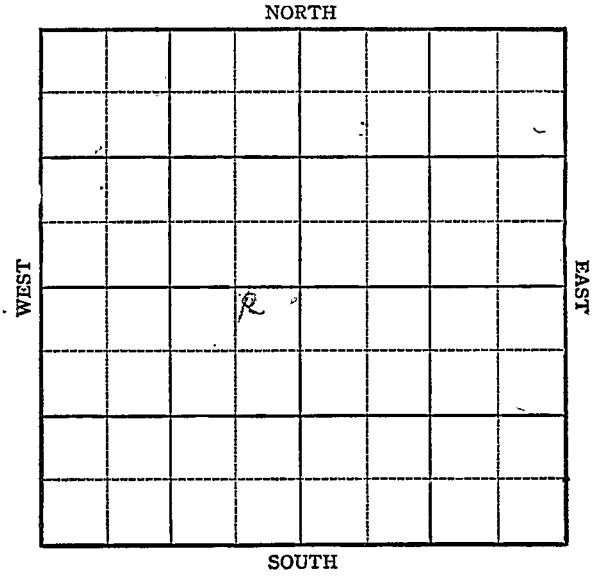

FORM 252-A
5M 9-44 PETROL

KANSAS

Haskell

Sec. 16 Twp. 30 R. 34W

Well No. #2 Stevens Farm

United Prod Company

Hugoton


100 Ft. from N. Line

Ft. from S. Line

Ft. from E. Line

100 Ft. from W. Line

NE SW Sec. 1974

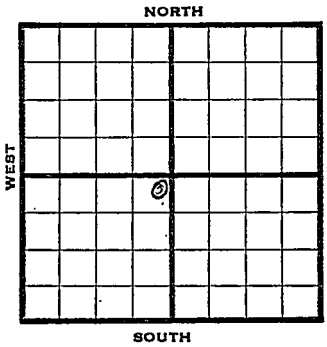

1945	REPORT
1/24	Location
1/31	10" @ 614'
	Drlg. 2330'
2/7	7" @ 2515 RUST
2/14	TD 2748
	270' of 5" Perf Liner @ 2748
2/21	8000 Acid
2/28	" "
3/7	" "
3/14	" "
3/23	" "
3/29	" "
4/4	7" @ 2515
	270' of 5" Perf Liner @ 2748
	8000 acid
	TD 2748
	16,338,000 Gas
	421# R Pr.

COMPLETED

FORM 56 200 BKS, 1-44 PETROL

Pool Name Hugoton

Map No. N M Sec. 16 Twp. 30 R. 34W


Well No. 2 Stevens

United Prod Company

FIRST REPORT Contractor

NE SW

SECTION PLAT

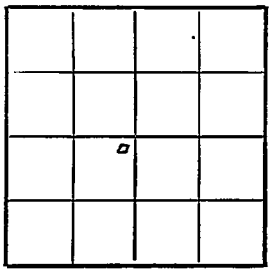

100 Ft. from N. Line

Ft. from S. Line

Ft. from E. Line

100 Ft. from W. Line

Haskell

Location X

Rig up

Drilling and Remarks:

RECORD

Cased in., ft.

Sand

Gas

Oil

Total Depth

PRODUCTION

1st 24 hrs. Nat.

1st 24 hrs. after shot

Gas Cu. Ft.

Dry Hole

Abandoned

Date

JAN 24 1945 19 S. J. LEWIS Scout

FORM 26 200 BKS 1-44 PETROL

Pool Name Hugoton

Map No. No Map Sec. 16 Twp. 30 R. 34W

Well No. 2 Stevens

United Prod Company

COMPLETED Contractor

NE SW


100 Ft. from N. Line

Ft. from S. Line

Ft. from E. Line

100 Ft. from W. Line

SECTION PLAT

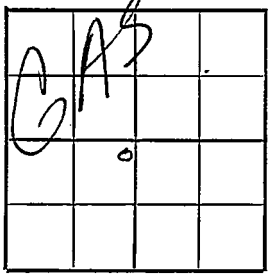

Haskell County

Location

Rig up

Drilling and Remarks:

7" @ 2515'.

270 sx 5" Perf. Liner

@ 2745

8000 Gal

16,338,000 Gas

421 # R Pr

RECORD

Cased in., ft.

Sand

Gas

Oil

Total Depth 2745

PRODUCTION

1st 24 hrs. Nat.

1st 24 hrs. after shot

Gas Cu. Ft.

Dry Hole

Abandoned

Date

APR 4 1945 19 S. J. LEWIS Scout