


Section 16 Township 30 Range 32W

Well No. #1 E. H. Elliott

Company Stanolind

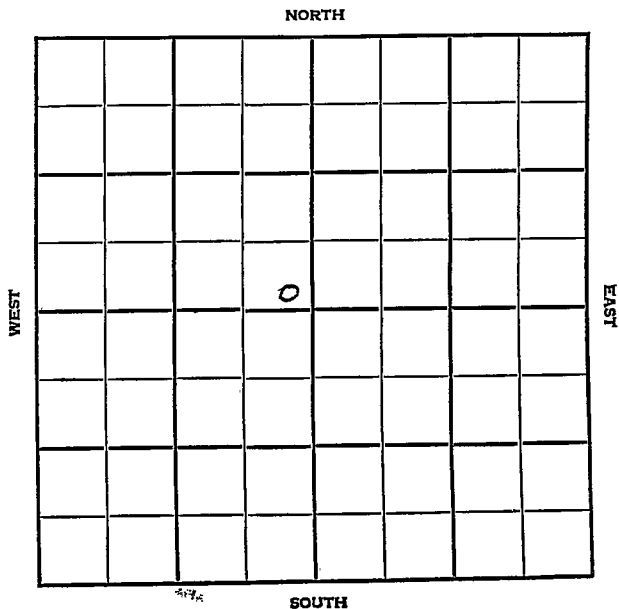

Haskell

KANSAS

SEC. 16	TWP. 30	R. 32W
------------	------------	-----------

WELL NO.
#1 ^E. H. Elliott FARM

COMPANY
Stanolind

CONTRACTOR
Noble Drlg.


_____ Ft. from N. Line

_____ Ft. from S. Line

_____ Ft. from E. Line

_____ Ft. from W. Line

SE SE NW 150' SL
100' WL

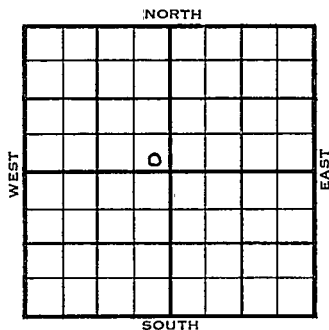

1955	ELEVATION 2885	REPORT
------	-------------------	--------

6/8
Comm 5-2-55
8" @ 680/400 5 1/2" @ 2724-900 DD 2734
190 mcfg 100 gaw 3000 A 1500 A 190
mcfg 200 A 3000 A 1500 A 2,299
mcfg PB 2715 36/2682-94, 40/2696
-2706 200A 5500 A 2700 A 2,603
mcfg 2,524 mcfg PB 2670 48/2652-64
4700 A 2,911 mcfg 2,602 mcfg 10,000
A 2,731 mcfg
Tops Depth
Anh. Herr 2643
Tp. Kri. 2695
H. Winf 2724
TD: 2728
Comp: open flow 9,121 mcfgpd

FIRST REPORT

↓

COMPLETED

County Haskell Elevation 2885
 Sec. 16 Twp. 30 Rge. 3 2W
 Company Stanolind
 Farm Name E. H. Elliott No. 1

TOPS	DEPTH	LOG	DATUM	CORRECTION
Anh. <u>Herr</u>	<u>2643</u>			
Tp. <u>Kri</u>	<u>2695</u>			SE SE NW
H. <u>Wind</u>	<u>2724</u>			150' SL
Tr.				100' WL
Dg.				
Bl.				
L.				Geol.
K.C.				Contr.
B.K.C.				Noble Drlg.
Ce.				
C.				
M.				Pool
M.				
K.				Hugoton
Mz.				
Me.				
V.				
S.				
S.				
A				
R.				
Pe.				
G.				
T.D.	<u>2728</u>			

Date Comm. 5-2-55 JUN 8 1955

8" @ 680/400 5 $\frac{1}{2}$ " @ 2724-900 DD 2734

190 mcfg 100 gaw 3000 A 1500 A

190 mcfg 200 A 3000 A 1500 A

2,299 mcfg PB 2715 36/ 2682-94

40/ 2696-2706 200 A 5500 A 2700 A

2,603 mcfg 2,524 mcfg PB 2670

48/ 2652-64 4700 A 2,911 mcfg

2,602 mcfg 10000 A 2,731 mcfg

Comp. open flow 9,121 mcfgpd

FIRST REPORT
0
COMPLETE