


Section 16 Township 30 Range 2-W

Well No. #2 Love

Company Eckland Drlg
Latta Pool

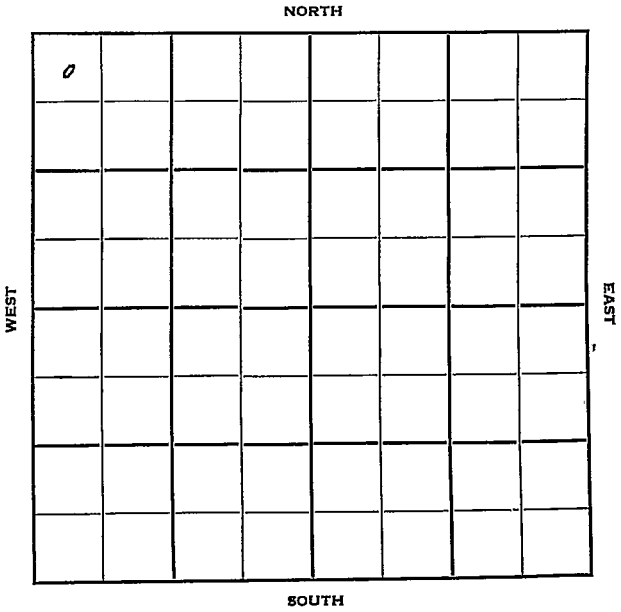



16

Sec. _____ Twp. _____ R. _____

#2 Love

Well No. _____ Farm _____

Edkland Drlg.

Company _____

Contractor _____

~~330~~ 330 Latta Pool


~~330~~ Ft. from N. Line

_____ Ft. from S. Line

_____ Ft. from E. Line

~~330~~
330 Ft. from W. Line

NW NW NW

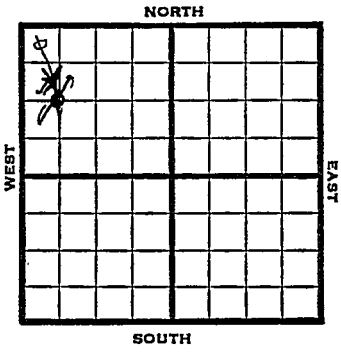

1950

Elev 1352' REPORT

3/1 Spud 2-27-50

3/15 TD 3294'
8 5/8" @ 80'
KC 3079'
D&A
Aband.

ABANDONED

Kansas

Map No. _____ Sec. 16 Twp. 30 R. 2^WWell No. 2 Love_____
Eckland Drlg. Company_____
Contractor

NW NW NW

330 Ft. from N. Line_____
Ft. from S. Line_____
Ft. from E. Line330 Ft. from W. Line

SECTION PLAT

0			
FIRST REPORT			

Sumner County

Location _____

Rig up _____

Drilling and Remarks:

Spud 2-27-50

RECORD

Cased _____ in., _____ ft.

Sand _____

Gas _____

Oil _____

Total Depth _____

PRODUCTION

1st 24 hrs. Nat. _____

1st 24 hrs. after shot _____

Gas _____ Cu. Ft.

Dry Hole _____

Abandoned _____

Date

MAR 1 1950J. E. TYRA Scout

Kansas

Map No. _____ Sec. 16 Twp. 30 R. 2W

Well No. 2 Love

Eckland Drlg. _____ Company

Contractor

NW NW NW

EI. 1352
SECTION PLAT

330 Ft. from N. Line

_____ Ft. from S. Line

_____ Ft. from E. Line

330 Ft. from W. Line

o			
ABANDONED			

Summer County

Location _____

Rig up _____

Drilling and Remarks:

8 5/8" @ 80

K.C. 3079

DJA

RECORD

Cased _____ in., _____ ft.

Sand _____

Gas _____

Oil _____

Total Depth 3294

PRODUCTION

1st 24 hrs. Nat. _____

1st 24 hrs. after shot _____

Gas _____ Cu. Ft.

Dry Hole _____

Abandoned _____

Date

MAR 15 1950 19

J. E. TYRA Scout