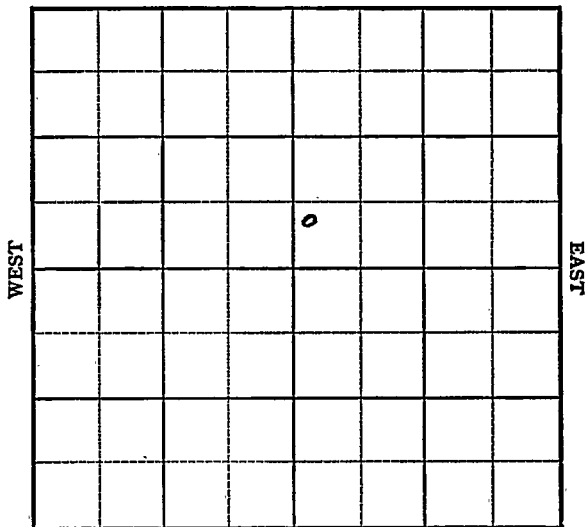


KANSASSection 16 Township 30 Range 37WWell No. 1 BousserCompany Hugton Prod.Hugton
NORTH

SOUTH

Grant

Sec. 16 Twp. 30 R. 37WWell No. #1 Bousser Farm

Hugoton Prod.

Company

Hugoton Pool (Burris Drlg., ~~NORTH~~ Cent.)

Ft. from N. Line


400'

Ft. from S. Line

Ft. from E. Line

100'

Ft. from W. Line

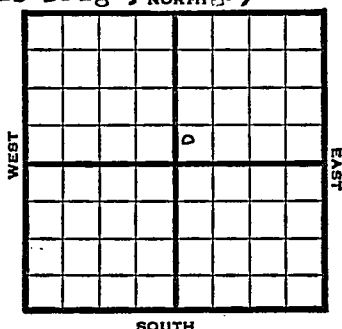

SW NE

SOUTH

1949

Elev. 3095' REPORT

9/7

Location

9/14

"

9/21

10" @ 557'

Drlg. 1997'

9/28

TD 2455'

7" @ 2448'

10/5

TD 2681'

10/12

253' of 5" Perf @ 2681 TD

10/19

3000 acid

10/26

7" @ 2448'

253' of 5" Perf liner @ 2681'

Acid 13,000

Gas 15,861,000 R Pr. 412#

TD 2681'

COMPLETED

Kansas

Hugoton Pool


Map No. _____ Sec. 16 Twp. 30 R. 37W

Well No. 1 Bousser

Hugoton Prod. _____ Company

Burris Drlg. _____ Contractor

SW NE

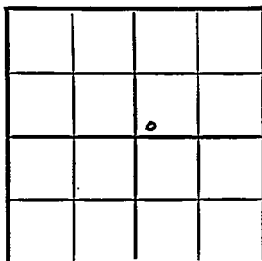FIRST REPORT
SECTION FLAT

_____ Ft. from N. Line

400 _____ Ft. from S. Line

_____ Ft. from E. Line

100 _____ Ft. from W. Line

Grant County

Location X

Rig up

Drilling and Remarks:

RECORD

Cased _____ in. _____ ft.

Sand _____

Gas _____

Oil _____

Total Depth _____

PRODUCTION

1st 24 hrs. Nat. _____

1st 24 hrs. after shot _____

Gas _____ Cu. Ft.

Dry Hole _____

Abandoned _____

Date

SEP 7 1949 19

S. J. LEWIS Scout

Kansas

Hugoton Pool

Map No. _____ Sec. 16 Twp. 30 R. 37WWell No. 1 Bousser

Hugoton Prod. _____ Company _____

COMPLETE

Contractor _____

SW NE

E1.3085
SECTION PLAT

_____ Ft. from N. Line


400

Ft. from S. Line

_____ Ft. from E. Line

100

Ft. from W. Line

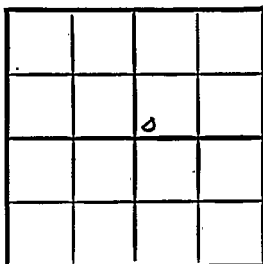

Grant County

Location _____

Rig up _____

Drilling and Remarks:

*7' C 2448**253' x 15" Prof liner**C 2687**130000 acid**15,861,000 gal**412# R/B*

RECORD

Cased _____ in., _____ ft.

Sand _____

Gas _____

Oil _____

Total Depth 2687

PRODUCTION

1st 24 hrs. Nat. _____

1st 24 hrs. after shot _____

Gas _____ Cu. Ft.

Dry Hole _____

Abandoned _____

Date

OCT 26 1949

19

S. J. LEWIS

Scout