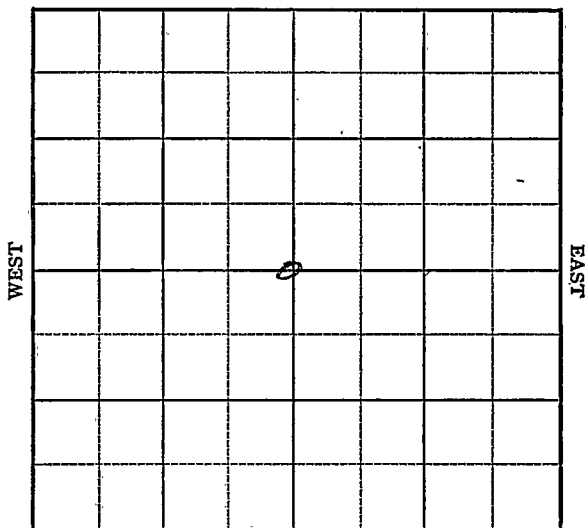


KANSAS

Grant

Section 16 Township 30 Range 38WWell No. 1 HennighCompany Hugoton Prod.Hugoton
NORTH

SOUTH

Grant

KANSAS

Sec. 16 Twp. 30 R. 38N

Well No. #1 Hennigh Farm

Hugoton Prod.

Company

Hugoton Pool (Burris, Cont.)

NORTH


2640' Ft. from N. Line

Ft. from S. Line

2640' Ft. from E. Line

Ft. from W. Line

C Sec.

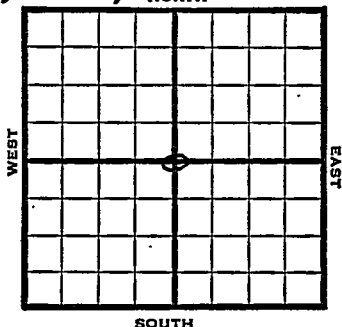

1949

Elv 3170' REPORT

7/20

RUR

7/27

10" @ 605'
Drlg 2425'

8/3

TD 2425'
7" @ 2412'

8/10

260' of 5" Perf liner @ 2651 TD

8/17

"

8;24

TD 2651'
7" @ 2412'
260' of 5" Perf Liner @ 2651'
2,020,000 Gas
427# R Br.
Comp

COMPLETED

Kansas

Map No. _____ Sec. 16 Twp. 30 R. 38W

Well No. 1 Hennigh

Hugoton Prod. _____ Company

Burris _____ Contractor

FIRST REPORT
SECTION PLAT


C Sec.

2640 _____ Ft. from N. Line

_____ Ft. from S. Line

2640 _____ Ft. from E. Line

_____ Ft. from W. Line

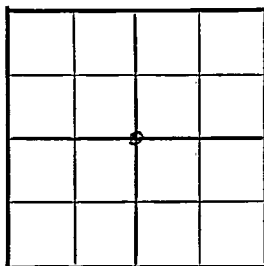

Grant County

Location _____

Rig up _____

Drilling and Remarks: _____

R U R

RECORD

Cased _____ in., _____ ft.

Sand _____

Gas _____

Oil _____

Total Depth _____

PRODUCTION

1st 24 hrs. Nat. _____

1st 24 hrs. after shot _____

Gas _____ Cu. Ft.

Dry Hole _____

Abandoned _____

Date

JUL 20 1949 19

S. J. LEWIS Scout

Map No. 4 Sec. 16 Twp. 30 R. 38WWell No. 1 Hennigh

Hugoton Prod.

Company

COMPLETE

Contractor

C Sec.

E1.8170


SECTION PLAT

2640 Ft. from N. Line

Ft. from S. Line

2640 Ft. from E. Line

Ft. from W. Line

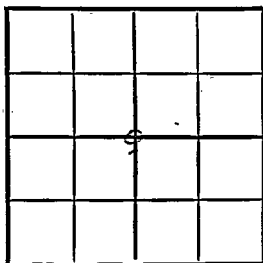

Grant County

RECORD

Location

Cased _____ in., _____ ft.

Rig up

Sand _____

Drilling and Remarks:

Gas _____

Oil _____

Total Depth 2651

PRODUCTION

1st 24 hrs. Nat. _____

1st 24 hrs. after shot _____

Gas _____ Cu. Ft.

Dry Hole _____

Abandoned _____

Date

AUG 24 1949 19

S. J. LEWIS

Scout