

Barber


FORM 51 25M 8-50 WESTERN

KANSAS

Section 17 Township 30 Range 15W


Well No. #1 Gypsum

Company Nadel & Gussman

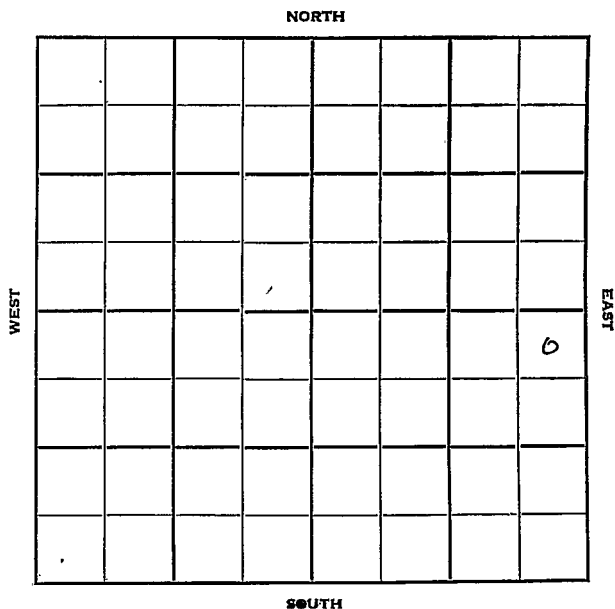

Sec. 17 Twp. 30 R. 15WWell No. #1 Gypsum Farm ☒Nadel & Gussman CompanyMorrison Contractor

Wildcat

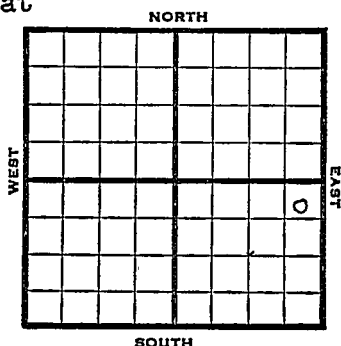330 Ft. from N. Line Ft. from S. Line330 Ft. from E. Line Ft. from W. Line

NE NE SE

1951 Elev. 1857' REPORT

11/28 Spud 11-19-51
10" @ 285'
Dr1g. 2505'1952
2/6 TD 4850 5" @ 4552
POP P/50 bopd

2/13 P/12 bopd

2/20 NR

3/5 Spud 11-19-51
Oil Well T 4850
10" @ 285'

Doug. 3838

Br Li 3970

KC 3989

Massey 4416-30

DST 4403-51 open 1 hr. rec. 15' mud

Cong. 4504

Kh 4509

Misener 4528

Maq. 4532

DST 4529-52 open 45 min. rec. 2300' gas

120' mud & oil Viola 4550

Simp. 4709

Arb. 4806

TD 4850 5" @ 4552 44/ 4541-53

1000 A S/ 3½ boph 10,000 gas

Hydro 1½ boph P/ 50 bopd

Comp. 25 bopd

COMPLETED

County **Barber** State **Kansas**

Sec. **17** (Blk. Twp.) **30** (Sur. Rge.) **15W** Map No.

Operator **Nadel & Gussman**

Well No. **1** Farm **Gypsum**

Elev.	Location	NE	NE	SE
-------	----------	----	----	----

FIRST REPORT

330 Ft. From N Line SE

330 Ft. From E Line Quarter

1st. Report **NOV 28 1951**

Completion

Remarks **Sinc. Phillips -DEM**

Morrison - Contr.

Spudding Date **11-19-51**

Drlg. Data **Wildcat**

10th @ 285 Drlg. 2505

J. E. TYRA.

J. G. McGEHEE